

Name **Jesse McDade**

Service No. 104

Address **39 Middleby Road****39 Middleby Rd.**

Location

Kind of Pipe

Size **6"**Size of Main **10"**~~REPAIR~~ **New Service** W.O. #2879 **Lexington Sewerage #2127**Location **AUG 14 1972**


Date	Material	Amount	Total	Date	Amount
26-66	Labor	87 68		8-24-72	186 11
	10% O.H.	8 77	96 45		
34'	6" Transite pipe @ .38		29 92	8-3-72	Renewal
1	Elbow		4 09	25'	6" Transite
1	Adapter		1 08		1 6"X1' Nipple
3	Collars @ 1.09		3 27		1 6"X6" Nipple
7	Ton stone @ 1.65		11 55		1 6"-90° Elbow
1	Ton cold patch		5 00		
4	Hrs. Trucking @ 3.00		12 00		
3 1/2	Hrs. Shovel @ 6.50		22 75		
			186 11		
	(TO BE BILLED WHEN CONNECTED)				
0-72	22' 6" Transite pipe				
	12' 4" Cast Iron pipe				

DATE \_\_\_\_\_

TOWN OF LEXINGTON — BOARD OF PUBLIC WORKS  
SEWER DIVISION

Sketch of Service Here

39

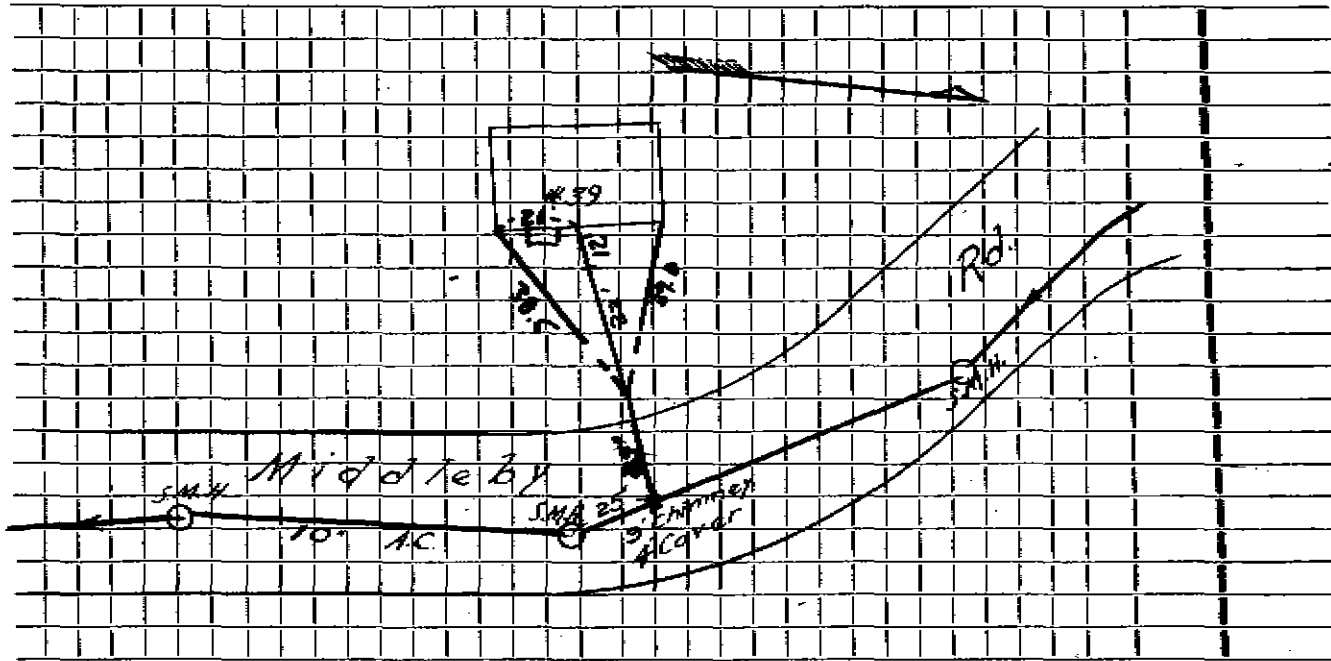

Connection made in ..... Street. Work completed .....

Remarks: .....  
.....  
.....