

Name

Service No.

Address

40 Middle by Rd.

Location

Kind of Pipe

Size 6"

Size of Main 10"

Repair—Remove—New Service

Location


Date	Material	Amount	Total	Date	Amount
-20-61					
48'	6" TRANSITE				
1	6" - 22 1/2 Bend				
1	6" - 11 1/4 Bend				
1	6" - 90° Elbow				

DATE \_\_\_\_\_

TOWN OF LEXINGTON — BOARD OF PUBLIC WORKS  
SEWER DIVISION

Sketch of Service Here

**40**

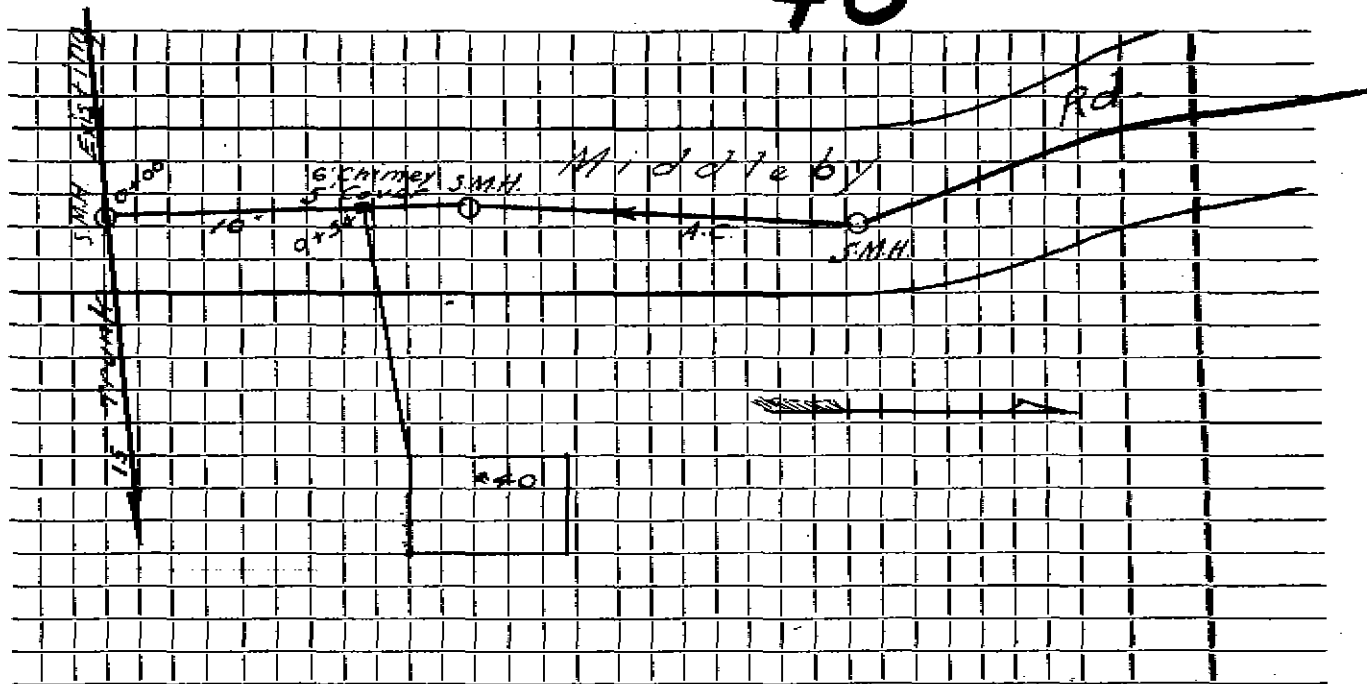

Connection made in \_\_\_\_\_ Street. Work completed \_\_\_\_\_

Remarks: \_\_\_\_\_  
 \_\_\_\_\_  
 \_\_\_\_\_