

Name **Custom Colonial Inc.**

Service No. **119**

Address **7 Middleby Road**

**7 Middleby Rd.**

Location

Kind of Pipe

Size **6"**

Size of Main **10"**

~~XXXXXXXXXX~~ — New Service W.O. #8203

Location **Comm 2-10-63**


Date	Material	Amount	Total	Date	Amount
30/63	Labor	119 10		9-16-63	300 00
	10% O.H.	11 91	131 01	2-10-63	51 03
	66" 6" Transite Pipe @ .82		54 12		248 97
	1 6" Service Saddle		5 25		
	1 90° Transite Elbow		4 09		
	3 Hrs. Town Shovel @ 6.50		19 50		
	3 Hrs. Trucking @ 3.00		9 00		
	1 Hr. Loader @ 5.00		5 00		
	1 Hr. Trailer @ 3.00		3 00		
	18 X 3 Patch		18 00		
			248 97		

DATE \_\_\_\_\_

TOWN OF LEXINGTON — BOARD OF PUBLIC WORKS  
SEWER DIVISION

Sketch of Service Here

7

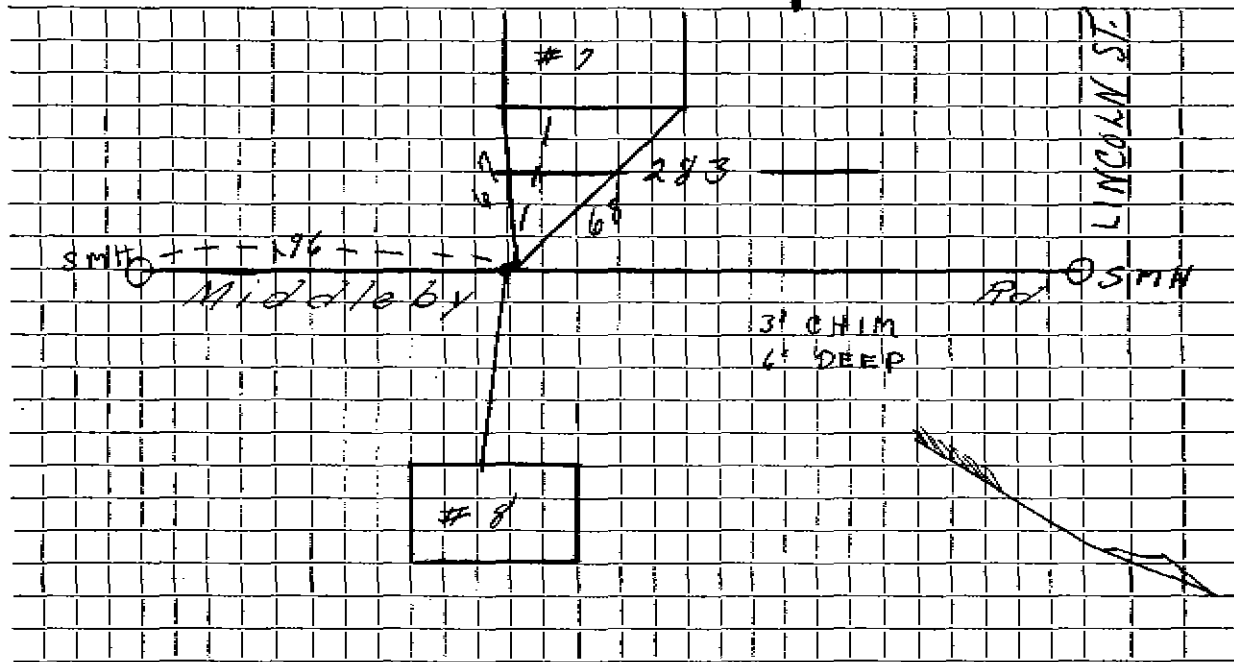

Connection made in ..... Street. Work completed .....

Remarks: .....

.....

.....