

Name

Service No.

Address 1 Militia Drive

Militia Drive

Location

Kind of Pipe

Size 6"

Size of Main 8"

Repair—Renewal—New Service

Location


Date	Material	Amount	Total	Date	Amount
				<u>1.19.09</u>	<u>MAIN Blockage paper & debris</u>

DATE _____

TOWN OF LEXINGTON — BOARD OF PUBLIC WORKS

SEWER DIVISION

Sketch of Service Here

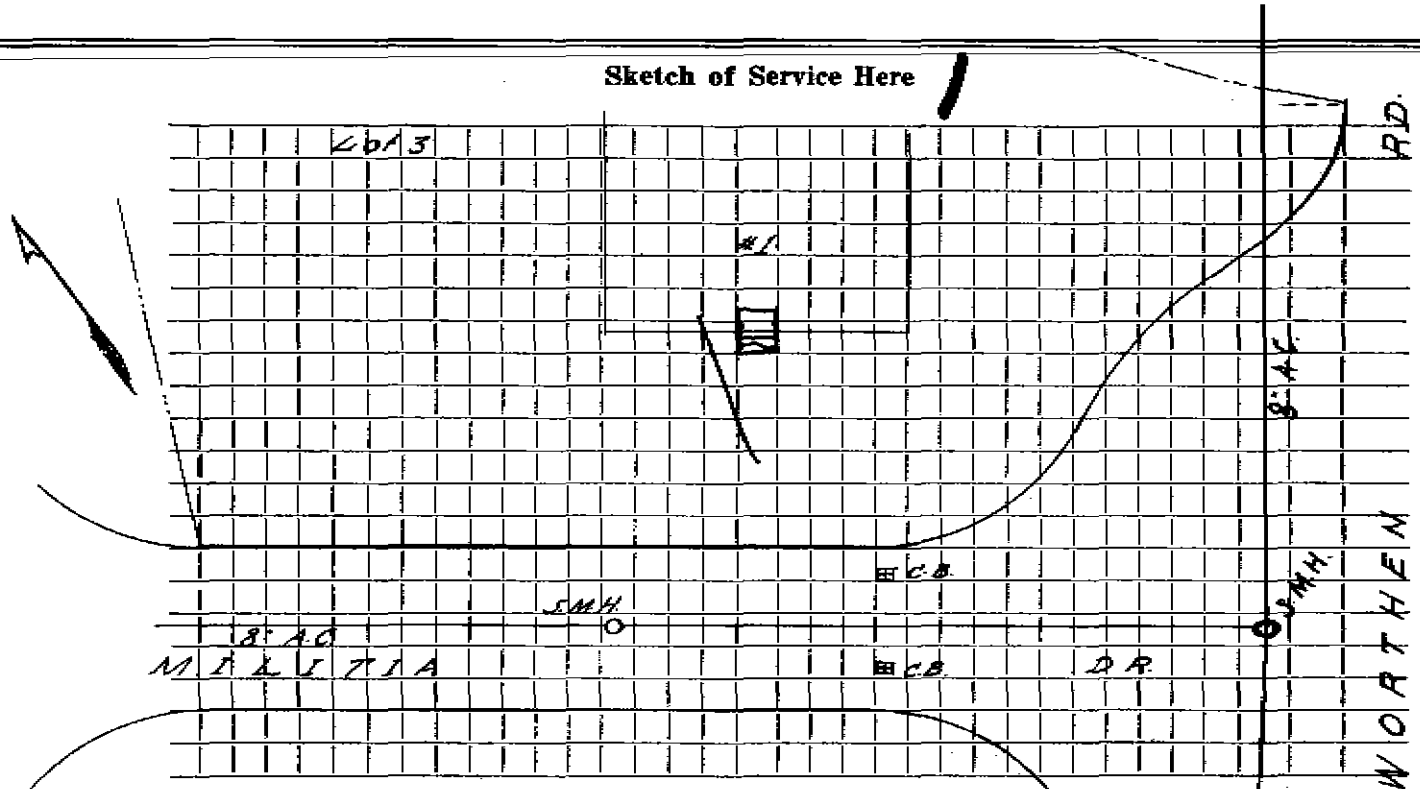

Connection made in MILITIA DR Street. Work completed

Remarks: OWNER-SAY'S SEWER COMES OUT LEFT OF DOOR