

Name A.J. Comeau (Sparton Bldg.)

Service No.

Address 2 Militia Drive

2 Militia Drive

Location

Kind of Pipe

Size 6"

Size of Main 8"

Repair—Renewal—New Service Piersiok #1470

Lucente #1053

Location

Date	Material	Amount	Total	Date	Amount
1/19/69	45' 6" Transite pipe				
	10' 4" Cast Iron pipe				
<del>1/21/68</del>	<del>30.5 6" Transite pipe</del>			6-21-68	
				38.6	6" Transite
					1 6"-22 1/2° Bend
					1 6"X8" Wye

DATE \_\_\_\_\_


TOWN OF LEXINGTON — BOARD OF PUBLIC WORKS

SEWER DIVISION

R.D.

Sketch of Service Here

2

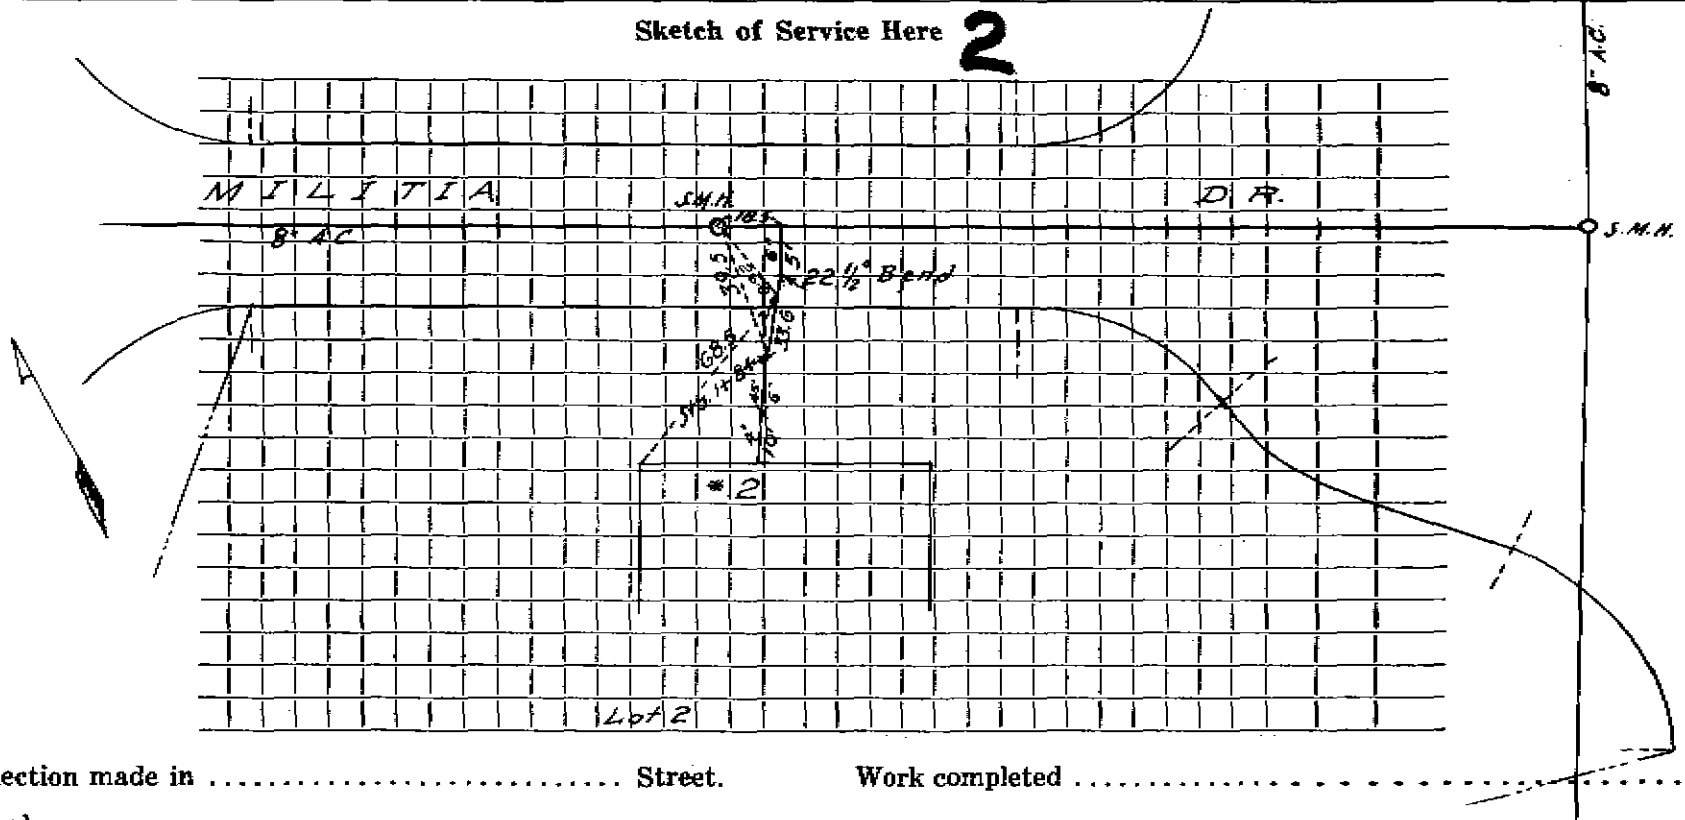

Connection made in ..... Street. Work completed .....

Remarks: .....

.....

.....