

Name Worthen Rd. Realty

Service No. \_\_\_\_\_

Address 3 Militia Drive (

3 Militia Drive

Location

Kind of Pipe

Size 6"

Size of Main 8"

Repair—Renewal—New Service Lucente #1054

Lucente #2191


Location

Date	Material	Amount	Total	Date	Amount
<del>2/1/68</del>	<del>70.6' 6" Transite pipe</del>				
<u>7/14/72</u>	68' 6" Transite			<u>6-21-68</u>	
	10' 4" Cast Iron			<u>76.6' 6" Transite</u>	
				<u>1 6" X 8" Wye</u>	

DATE \_\_\_\_\_

TOWN OF LEXINGTON — BOARD OF PUBLIC WORKS

SEWER DIVISION

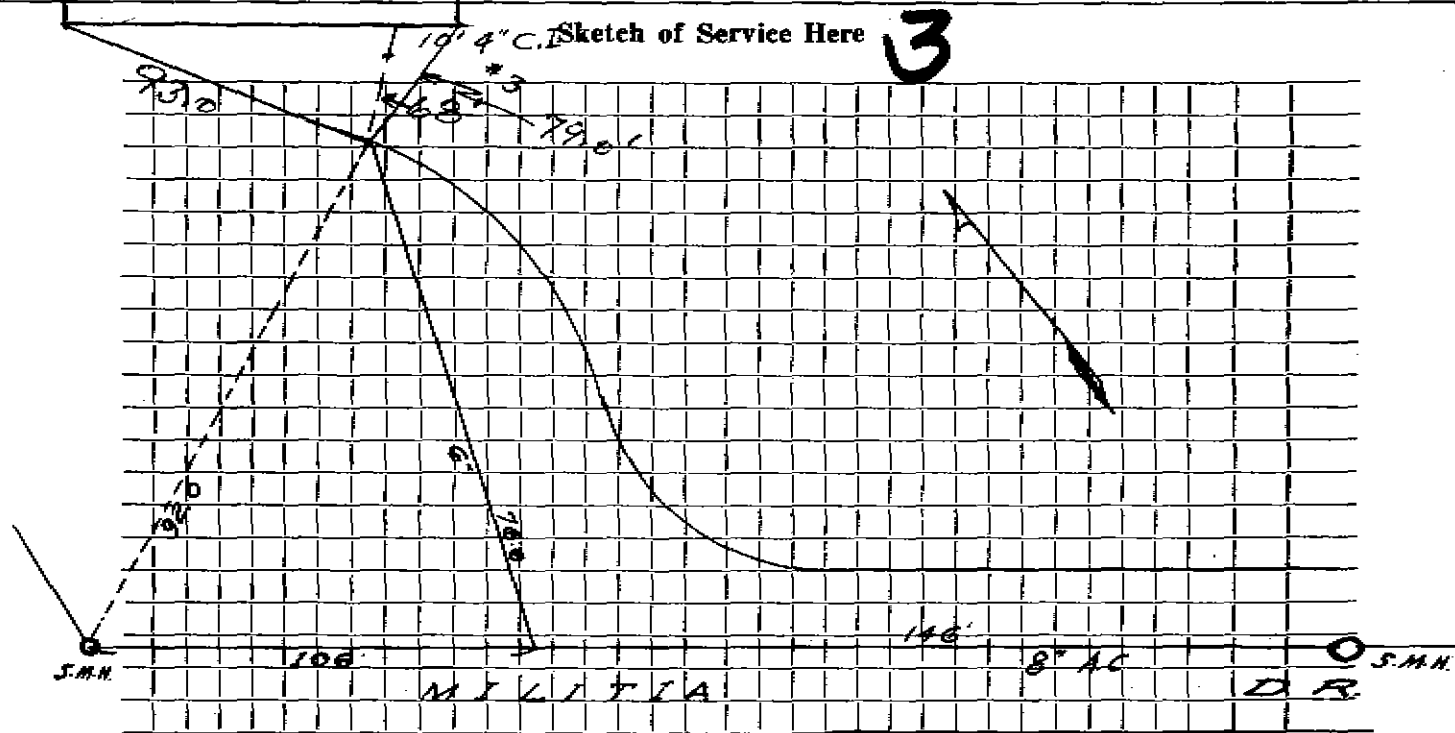

Connection made in ..... Street. Work completed .....

Remarks: .....

.....

.....