

Name **Worthen Rd. Realty**

Service No.

Address **4 Militia Drive**

Location

Kind of Pipe

Size **6"**

Size of Main **8"**

Repair—Renewal—New Service **Lucente # 1052**


Location

Date	Material	Amount	Total	Date	Amount
4-19-68	74' 6" Transit pipe				
				6-19-68	
				79' 6" TRANSITE	
				1 6" X 8" WYE	

DATE _____

TOWN OF LEXINGTON — BOARD OF PUBLIC WORKS

SEWER DIVISION

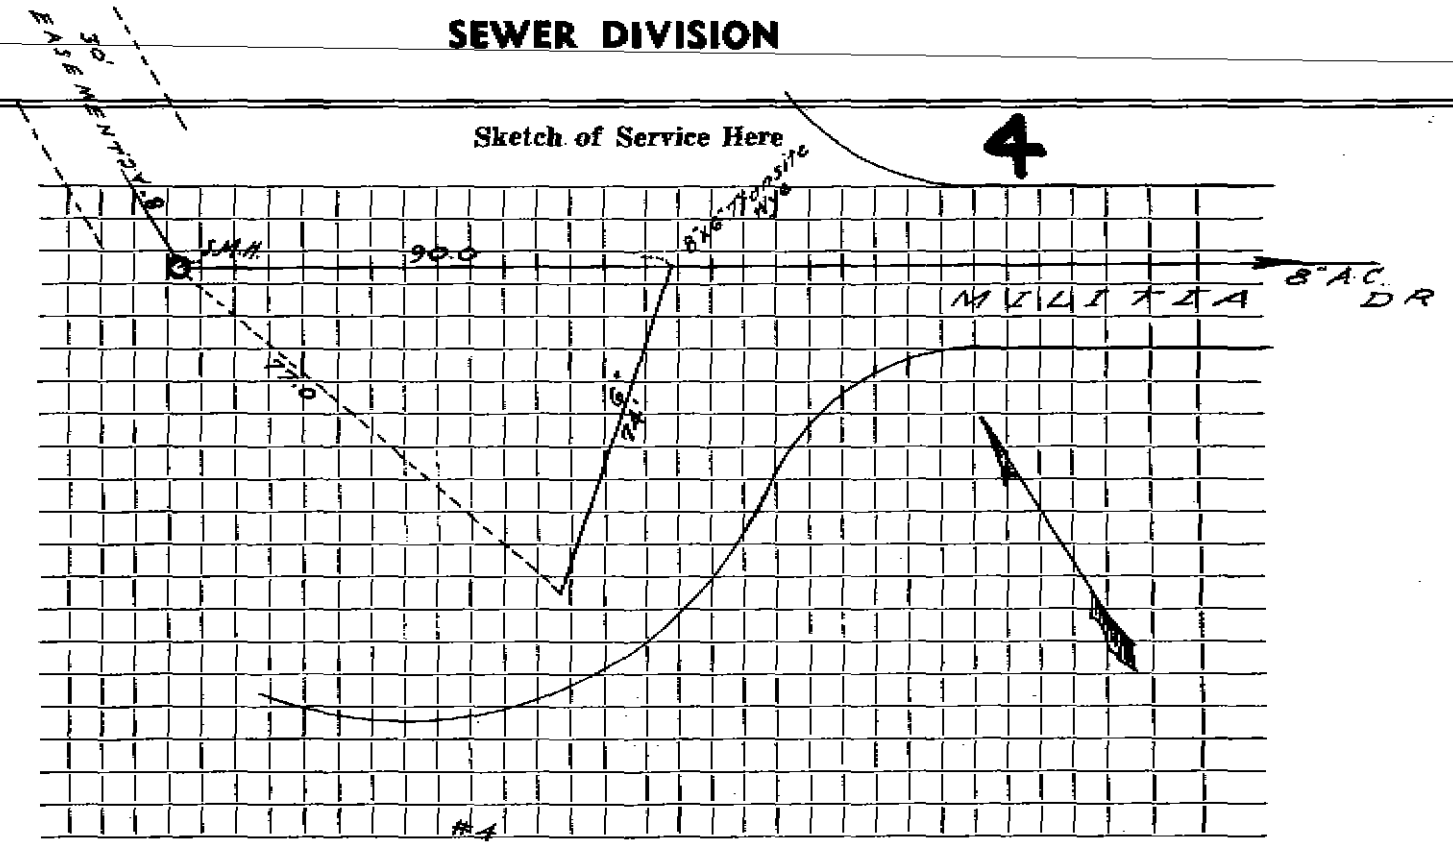

Connection made in Street. Work completed

Remarks:
.....
.....