

Name

Service No.

Address 6 MILK ST

PULASKI

Location

Kind of Pipe

Size

Size of Main

Repair ~~Renewal~~ New Service

Location

Date

Material

Amount

Total

Date

Amount

10/20/12

6" SDR

6" CLEANOUT (2)

.6" PVC LAP

.6" SDR RISER


.6" TEK WYU

22', 48' DENO
PVC

DATE 10/20/12

TOWN OF LEXINGTON — BOARD OF PUBLIC WORKS
SEWER DIVISION

Sketch of Service Here

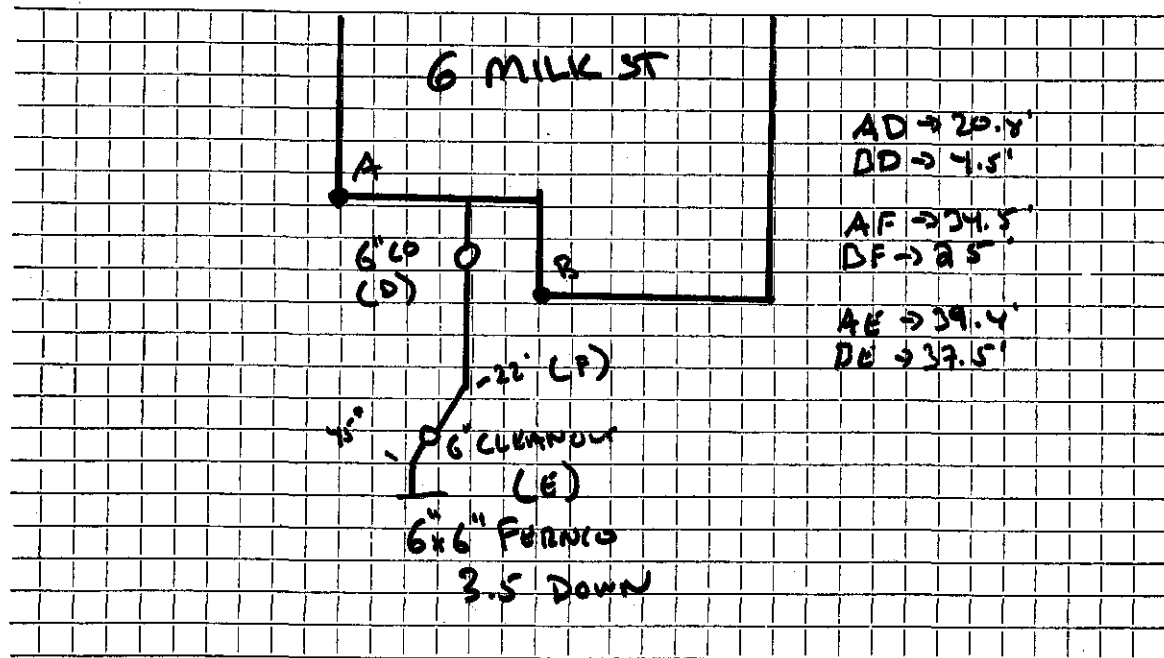

Connection made in MILK Street. Work completed PECORA CONSTRUCTION

Remarks: