

Name

Service No.

Address

8 MILK ST

MILK CLUMP

Location

Kind of Pipe

Size

Size of Main

Repair—~~Renewal~~—New Service

Location

Date

Material

Amount

Total

Date

Amount

10/2016

6" SDR

6" CLEAN OUT

6" CAP

6" TRU WYE

6" SDR RISER


45° BEND

?

6" x 6" FURNACE

DATE 6/7/2016

TOWN OF LEXINGTON — BOARD OF PUBLIC WORKS
SEWER DIVISION

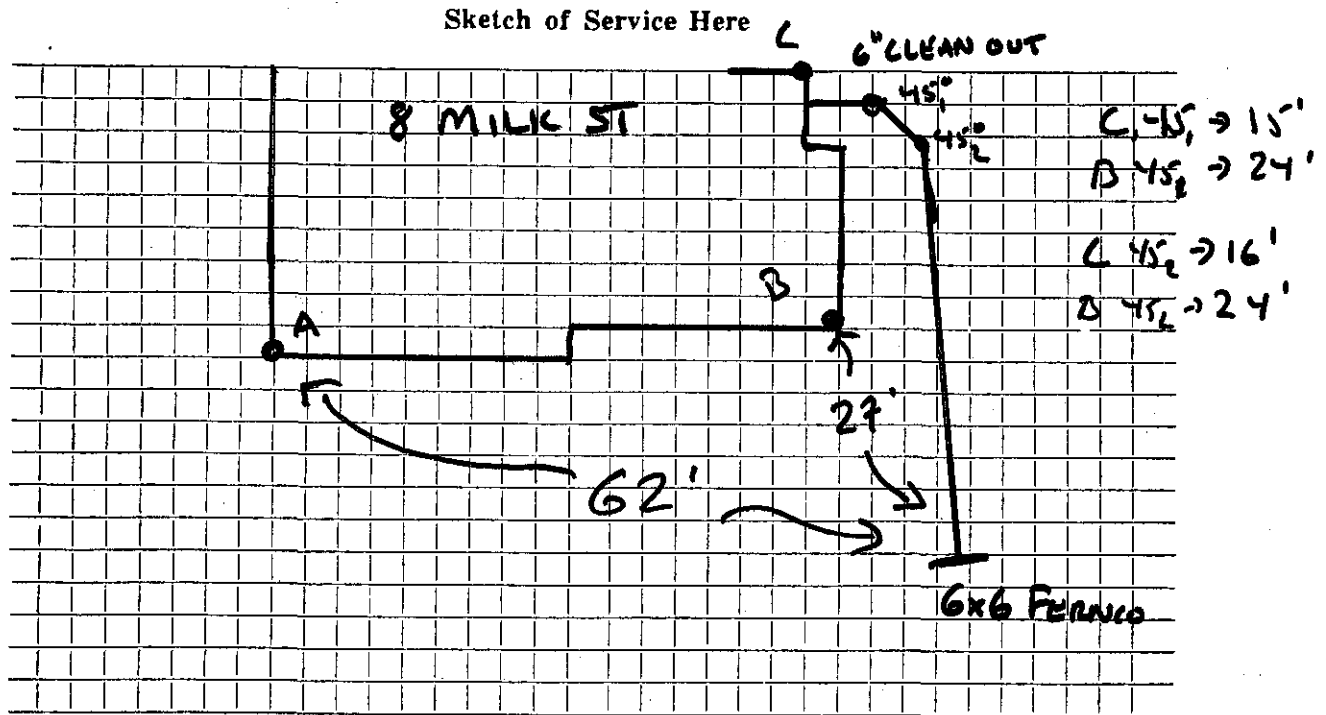

Connection made in ... MILK Street.

Work completed . MICHAEL CLARY

Remarks:

.....

.....