

Name Richard C. Fay

Service No. 89

Address 10 MILK ST.

Location 10 MILK ST.

Kind of Pipe

Size

Size of Main

~~REPAIR~~ New ServiceLocation *Corner 7th St*

Date	Material	Amount	Total	Date		Amount
1956	21' 6" V.C. Sewer Pipe			6-17-59	Deposit	150.00
	installed by contractor @ 3.00		63.00	7-6-59	Retained	24.16
6-18-59	Labor	38.40		1966		125.84
	10% O.H.	3.84	42.24		21' 6" V.C. Sewer Pipe	
	18' 6" Transite pipe @.70		12.60			
	1 hr. Town Shovel @ 6.50		6.50			
	2 hrs. Trucking @.75		1.50			
			125.84			
	Labor					
HP-6411						

TOWN OF LEXINGTON—DEPT. OF PUBLIC WORKS
SEWER DIVISION

DATE

NO.

The undersigned applies for the construction of a particular sewer connecting No.
Street and hereby agrees to comply with the Rules and Regulations governing the construction and use of Particular
Sewers, as now or at any future time established by the Board of Selectmen.


Am't of estimate \$.....

Am't Paid \$.....

..... Owner

Sketch of Service Here

10

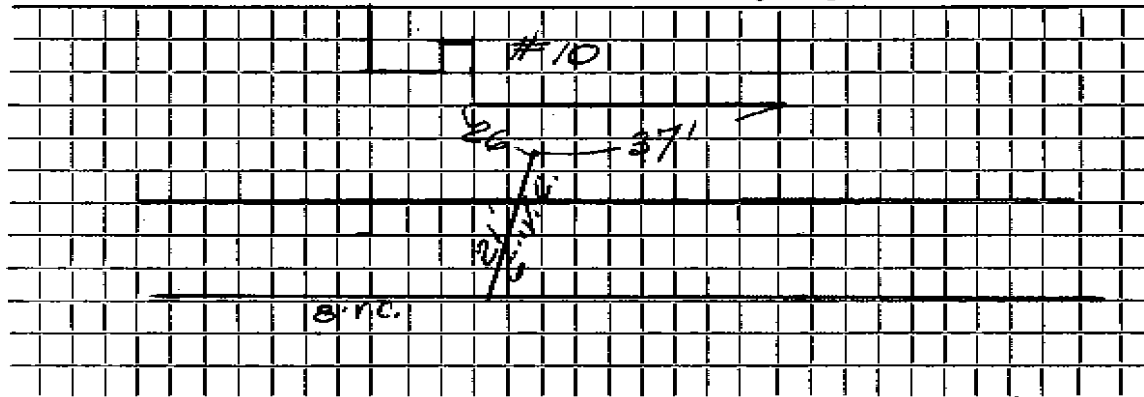

Connection made in Street.

Work completed 19..

Remarks: