

Name **Elta M. Beckett**

Service No. **81**

Address **12 Milk Street**

Lexington, Mass.

Location **12 MILK ST.**

Kind of Pipe

Size

Size of Main

~~REPAIRS~~ **New Service**

COMMITTED 10-15-51

Location

Date	Material	Amount	Total	Date	Amount
11/51	Labor	10 30	10 30	7-21-51	Deposited 100 00
	10% overhead		1 03	10-15-51	Refunded 34 21
	40' -6" sewer pipe @ .342		13 68		65 79
	1 - 6" elbow		1 88		
	joint compound		2 40		
	5 hrs. Littlefield shovel		35 00		
	2 hrs. trucking		1 50		
			65 79		
	Labor				

TOWN OF LEXINGTON—DEPT. OF PUBLIC WORKS
SEWER DIVISION

DATE

NO.


The undersigned applies for the construction of a particular sewer connecting No.
Street and hereby agrees to comply with the Rules and Regulations governing the construction and use of Particular
Sewers, as now or at any future time established by the Board of Selectmen.

Am't of estimate \$.....

Am't Paid \$.....

..... Owner

Sketch of Service Here

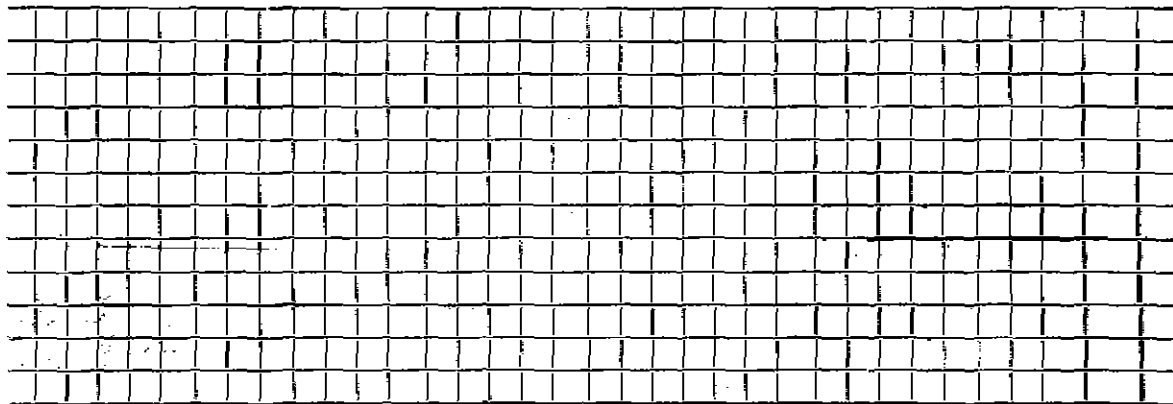

Connection made in Street.

Work completed 19..

Remarks: