

Name John Rachel

Service No. 67

Address 13 Milk Street

Lexington

Location 13 Milk St.

Kind of Pipe

Size

Size of Main

~~REPAIR~~ New Service COM. 9/8/52

Location

Date	Material	Amount	Total	Date	Amount
7/24/52	Labor	26 82		5-12-52	Deposited 104 10
	10% overhead	2 66	29 88	9-10-52	Refunded (17 87)
	36' - 6" sewer pipe @ .342		12 31		22 13
	1 - 6" elbow		1 88		
	joint compound		2 16		
	5 hrs. Littlefield shovel		35 00		
	2 hrs. trucking		1 50		
			82 13		
	Labor				

TOWN OF LEXINGTON—DEPT. OF PUBLIC WORKS
SEWER DIVISION

DATE.....

NO.....


The undersigned applies for the construction of a particular sewer connecting No.....
Street and hereby agrees to comply with the Rules and Regulations governing the construction and use of Particular
Sewers, as now or at any future time established by the Board of Selectmen.

Am't of estimate \$.....

Am't Paid \$.....

..... Owner

Sketch of Service Here

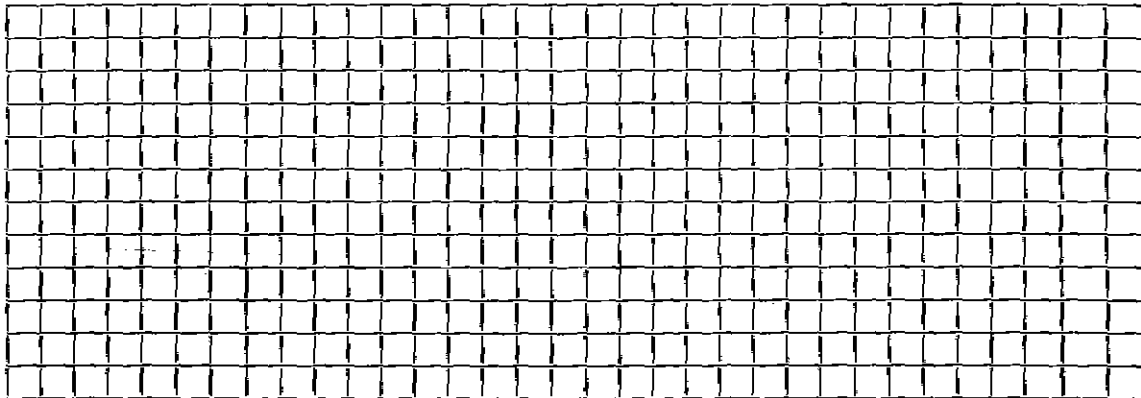

Connection made in..... Street.

Work completed.....19..

Remarks: