

Name **Leland - McConchie**

Service No. **108**

Address **3 Milk Street**

Lexington, Mass.

Location **3 MILK ST.**

Kind of Pipe

Size

Size of Main

~~REPAIR~~ **New Service COM. 10-15-51**

Location

Date	Material	Amount	Total	Date		Amount
1/23/51	Labor	19 05	19 05	<i>8-28-51</i>	<i>Deposited</i>	50 40
	10% overhead		1 91	<i>10-15-51</i>	<i>Refunded &</i>	5 83
	54' - 6" sewer pipe @ .342		18 47		<i>credited to S.N.C. #120</i>	
	joint compound		3 24		<i>1950</i>	44 17
	2 hrs. trucking		1 50			
			44 17			
	TRENCH DUG BY OWNER					
	Labor					

TOWN OF LEXINGTON—DEPT. OF PUBLIC WORKS
SEWER DIVISION

DATE

NO.


The undersigned applies for the construction of a particular sewer connecting No.
Street and hereby agrees to comply with the Rules and Regulations governing the construction and use of Particular
Sewers, as now or at any future time established by the Board of Selectmen.

Am't of estimate \$.....

Am't Paid \$.....

..... Owner

Sketch of Service Here

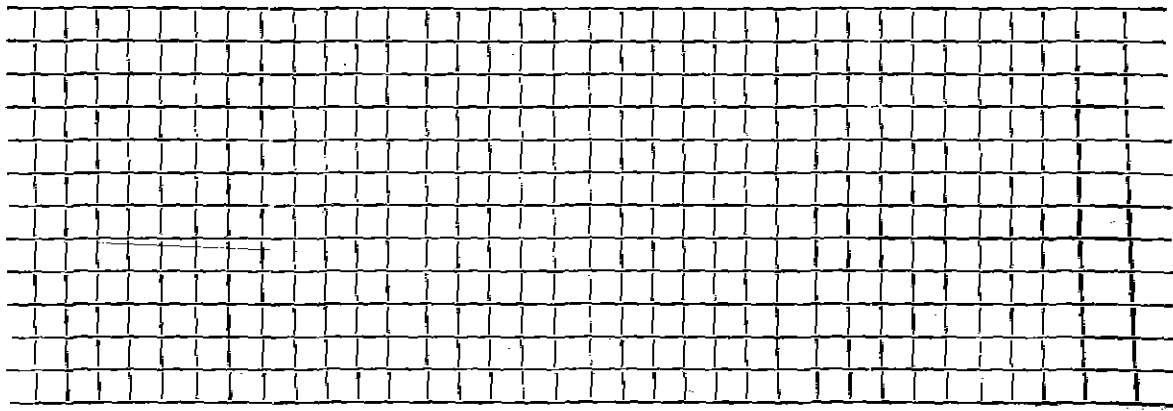

Connection made in Street.

Work completed 19..

Remarks: