

Name **William Sullivan**

Service No. • 101

Address **4 Milk Street**

Lexington, Mass.

Location **4 MILK ST.**

Kind of Pipe

Size

Size of Main

Repair—Renewal—New Service

COM. 10-15-51

Location

Date	Material	Amount	Total	Date	Amount
'15/51	Labor	4 81		8-23-51	125 00
'17/51	"	14 54	19 35	10-15-51	38 23
	10% overhead		1 94		26 77
	50' - 6" sewer pipe @ .342		17 10		
	1 - 6" elbow		1 88		
	joint compound		3 00		
	6 hrs. Littlefield shovel		42 00		
	2 hrs. trucking		1 50		
			86 77		
	Labor				
1/13/58	REPAIRED	9' 6" PVC	FERNCO		

TOWN OF LEXINGTON—DEPT. OF PUBLIC WORKS

SEWER DIVISION

DATE


NO.

The undersigned applies for the construction of a particular sewer connecting No. Street and hereby agrees to comply with the Rules and Regulations governing the construction and use of Particular Sewers, as now or at any future time established by the Board of Selectmen.

Am't of estimate \$.....

Am't Paid \$.....

..... Owner

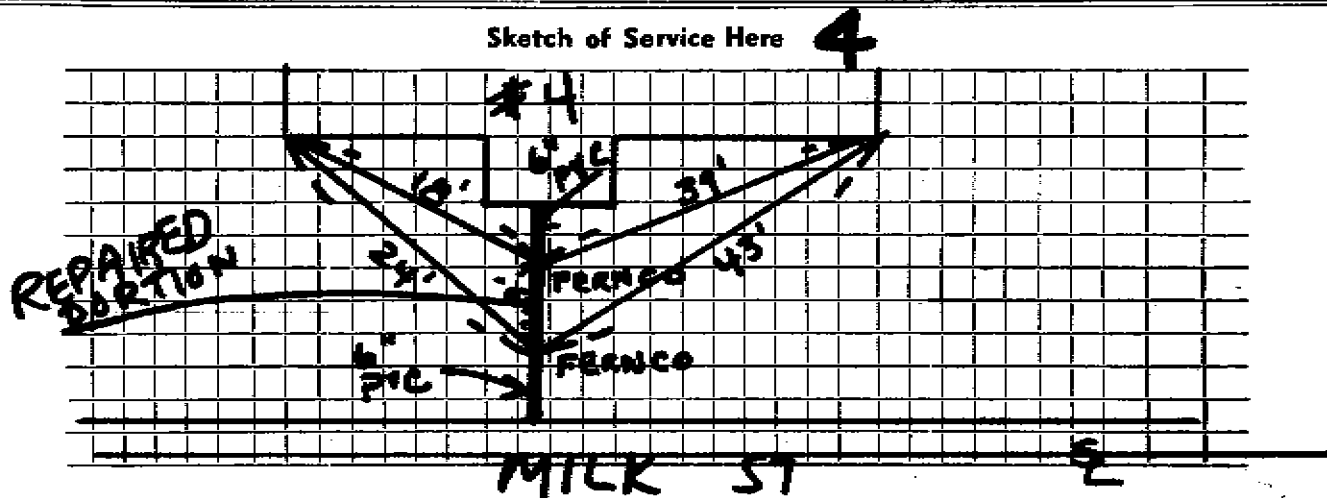

Connection made in Street.

Work completed 19..

Remarks: