

Name **Leland - McConchie**

Service No. **108**

Address **5 Milk Street**

Lexington, Mass.

Location **5 MILK ST.**

Kind of Pipe

Size

Size of Main

~~XXXXXXXXXX~~ - New Service

COM. 10-15-51

Location

Date	Material	Amount	Total	Date	Amount
3/25/51	Labor	25 20	25 20	8-25-51	50 10
	10% overhead		2 52	10-15-51	73
	54' - 6" sewer pipe @ .342		18 47		50 73
	joint compound		3 24		
	2 hrs. trucking		1 50		
			50 73		
	Labor				

TOWN OF LEXINGTON—DEPT. OF PUBLIC WORKS
SEWER DIVISION

DATE

NO.


The undersigned applies for the construction of a particular sewer connecting No.
 Street and hereby agrees to comply with the Rules and Regulations governing the construction **and use of Particular**
 Sewers, as now or at any future time established by the Board of Selectmen.

Am't of estimate \$.

Am't Paid \$.

..... Owner

Sketch of Service Here

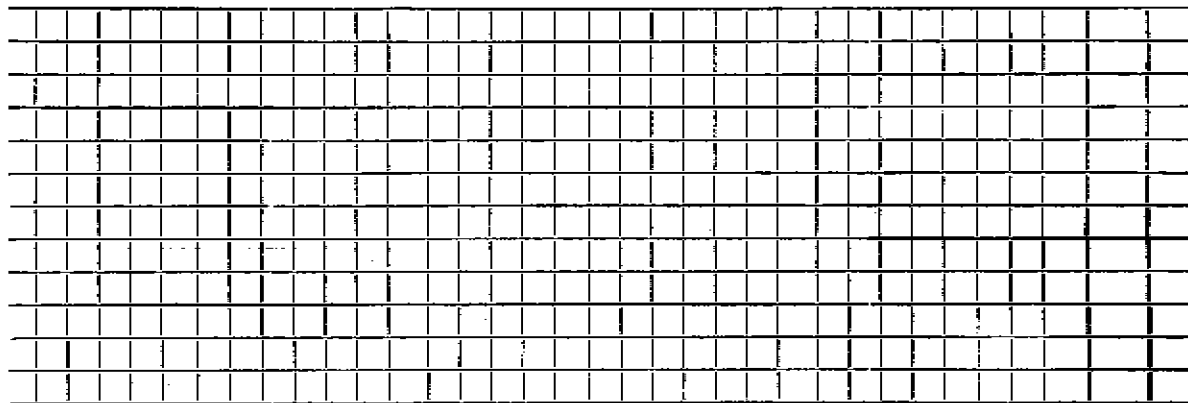

Connection made in Street.

Work completed 19..

Remarks: