

Name

Service No. 2536

Address 7 MILK ST

Location

LOT 43

Kind of Pipe PVC

Size 6"

Size of Main

Repair—Renewal—New Service
J. McLaughlin

Location


Date	Material	Amount	Total	Date	Amount
8/10/07	4' s.c. to 4x6 6" PVC				
1	4x6 Ferroc				
1	6" PVC x AC Ferroc	5 Duro			
EXIST 1971	A.C. by owner				
SERVICE 1957	Clay Maybe in STP				

TOWN OF LEXINGTON — BOARD OF PUBLIC WORKS

SEWER DIVISION

DATE _____

Sketch of Service Here

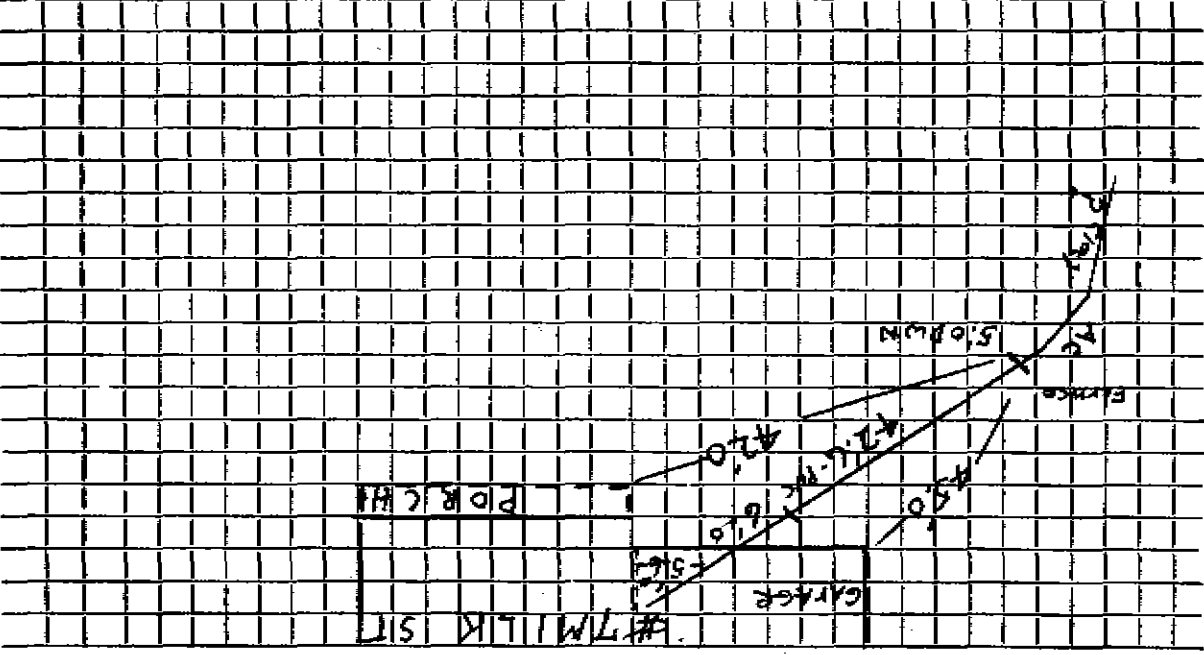

Work completed 8/10/07 J-M.L.

Street.

Connection made in

Remarks: 1971 OWNER - A.S. May. b.s. clay in SI