

Name ~~XXXXXXXXXX~~ Keith A. Randall

Service No. ¹⁹⁷⁷
~~21~~

Address #1 MILLBROOK RD.

JUN 20 1977

Location

Kind of Pipe

Size

6" A.C.

Size of Main

8" A.C.


~~XXXXXXXXXX~~ - New Service Valeri #3136

Location

Date	Material	Amount	Total	Date	Amount
4/17/73	210' @ 9.00	\$189.00		4/20/77	Deposit 189.00
4/21/77	135' 6" Transite Pipe				
	10' 4" Cast Iron Pipe			4-17-73	
	10' 1 1/2" Cast Iron Pipe				
4-25-96	Renewal			21' 6" Transite	
	17' 6" P.V.C.			1 6" X 8" Wye	
	1 6" X 4" Ferroc				

TOWN OF LEXINGTON — BOARD OF PUBLIC WORKS

SEWER DIVISION

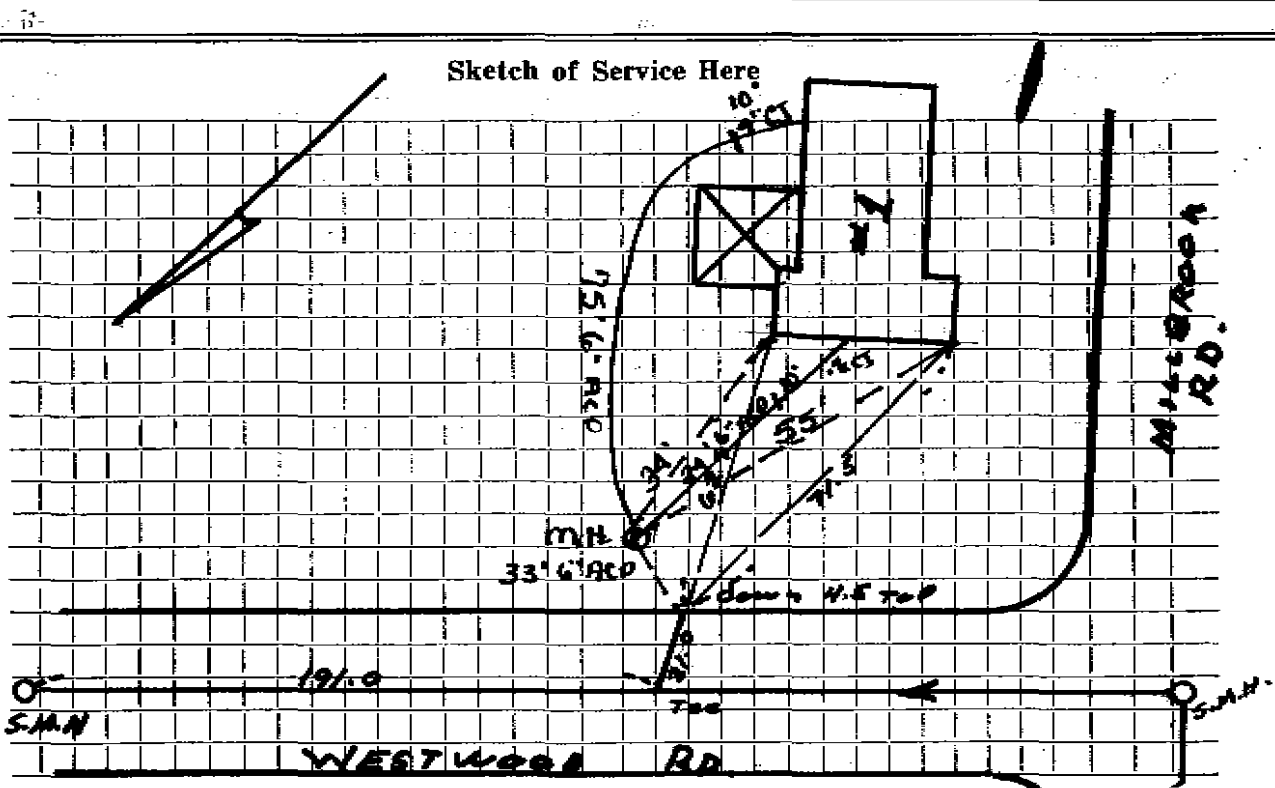

Connection made in Street. Work completed

Remarks:
.....
.....