


DATE _____

TOWN OF LEXINGTON — BOARD OF PUBLIC WORKS
SEWER DIVISION

Sketch of Service Here

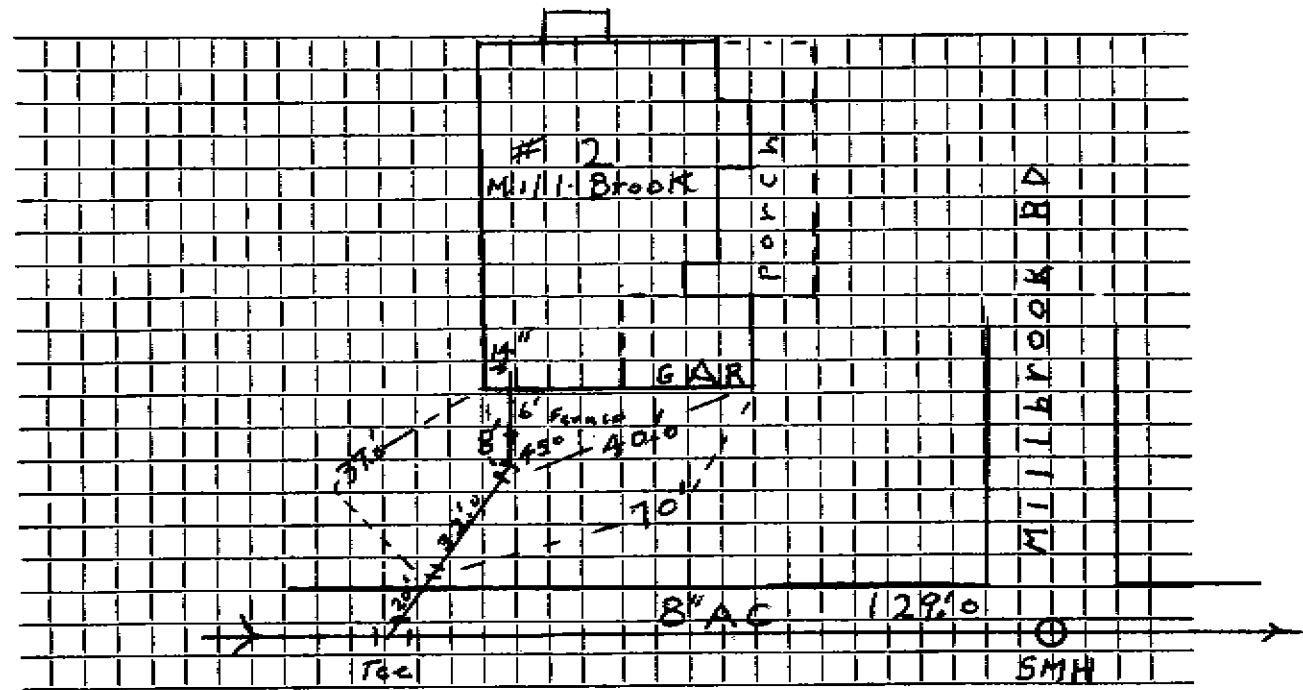

Connection made in ADAMS ST. Street, Work completed 5/20/08 J.M. Cloughlin

Remarks: 20' 6" AC Tee To Factory w/ 22 1/2' bend F.O. Dwyer