


DATE 4/28/22

TOWN OF LEXINGTON — BOARD OF PUBLIC WORKS
SEWER DIVISION

Sketch of Service Here

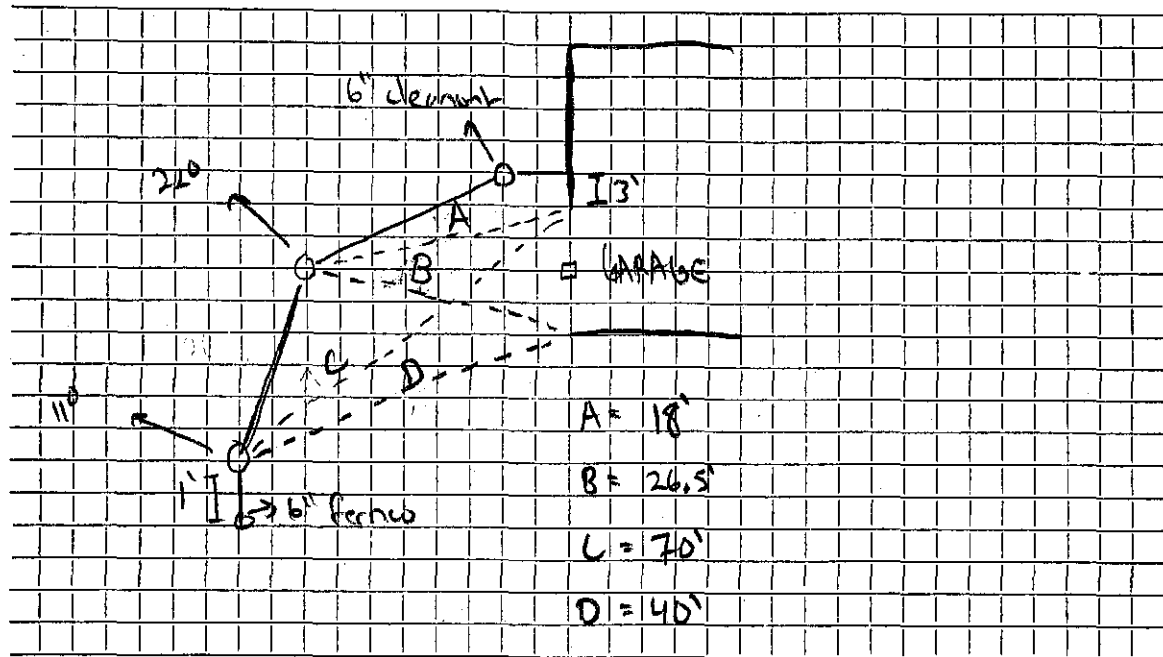

Connection made in Street. Work completed

Remarks: ..INSTALLED... BY... KIEWIT... EXCAVATING.....