


TOWN OF LEXINGTON — BOARD OF PUBLIC WORKS  
SEWER DIVISION

DATE 5/6/21

Sketch of Service Here

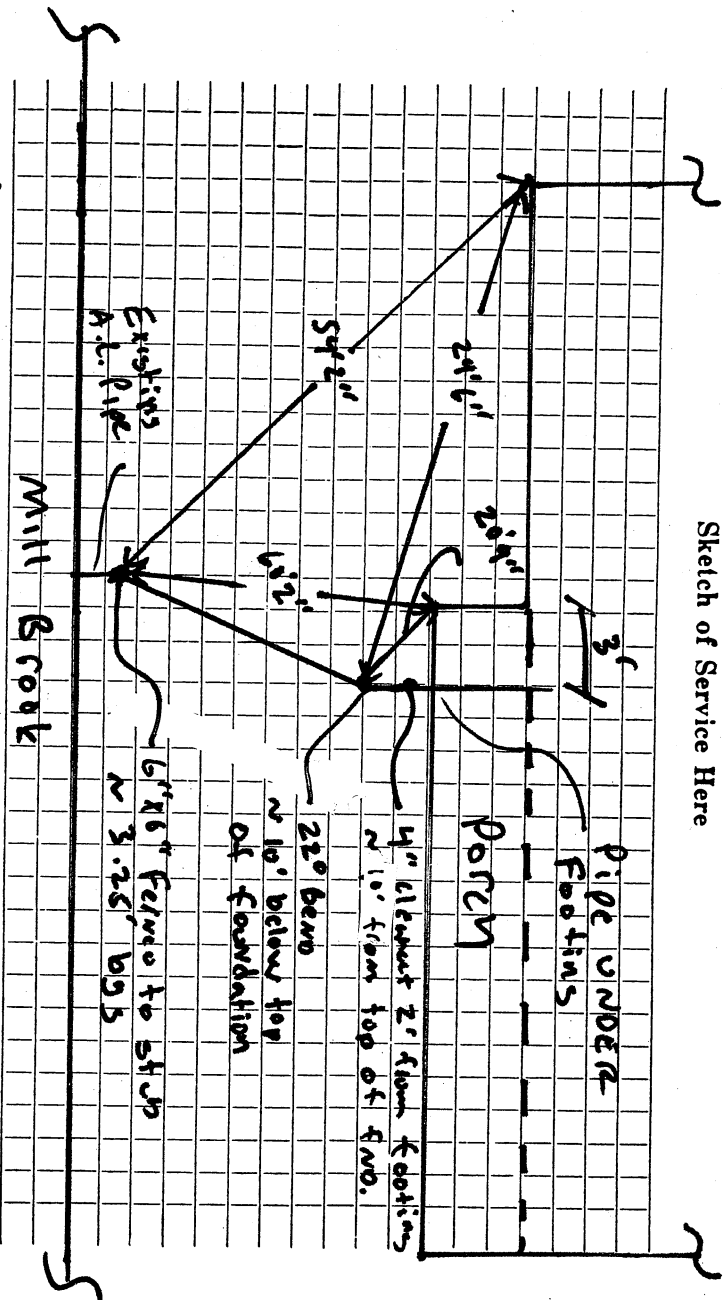

Connection made in ..... Mill Brook ..... Street ..... Work completed .....

Remarks: ..... RENEWAL .....



Name **Emanuele Coscia, Jr.**

Service No. **35**

Address **6 Mill Brook Road**

**JUN 18 1973**

Location

Kind of Pipe

Size **6"**

Size of Main **8"**

~~REPAIR WORK~~ **New Service** Kel-Scot Corporation #2277


Location

Date		Material	Amount		Total	Date		Amount	
4-28-73	30'	4" cast iron				4-27-73	<i>Deposit</i>	1180	00
	45'	6" transite				4-17-73	20' 6" Transite		
							1 6" x 8" Wye		

DATE \_\_\_\_\_

TOWN OF LEXINGTON — BOARD OF PUBLIC WORKS

SEWER DIVISION

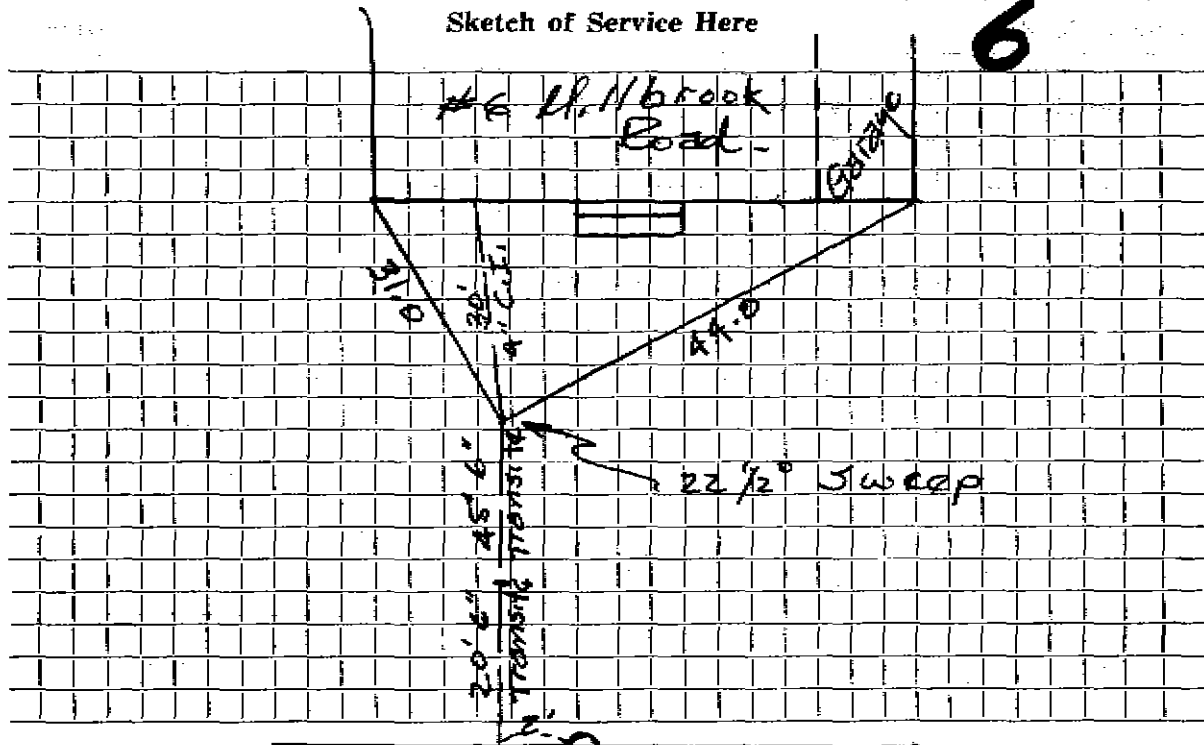

Connection made in ..... Street. 5m H. Work completed .....

Remarks: .....

.....

.....