

Name

Service No.

Address 8 Millbrook Rd.

Location

Kind of Pipe

Size

Size of Main

Repair—Renewal—New Service


Location

Date	Material	Amount	Total	Date	Amount
Sept 2001	61' 6" PVC				
	6' 4" PVC				
	1-6"x6" PVC to AC FEMCO				
	1-22.5° x 6" Bend				

DATE Sept 2001

**TOWN OF LEXINGTON — BOARD OF PUBLIC WORKS**  
**SEWER DIVISION**

Sketch of Service Here

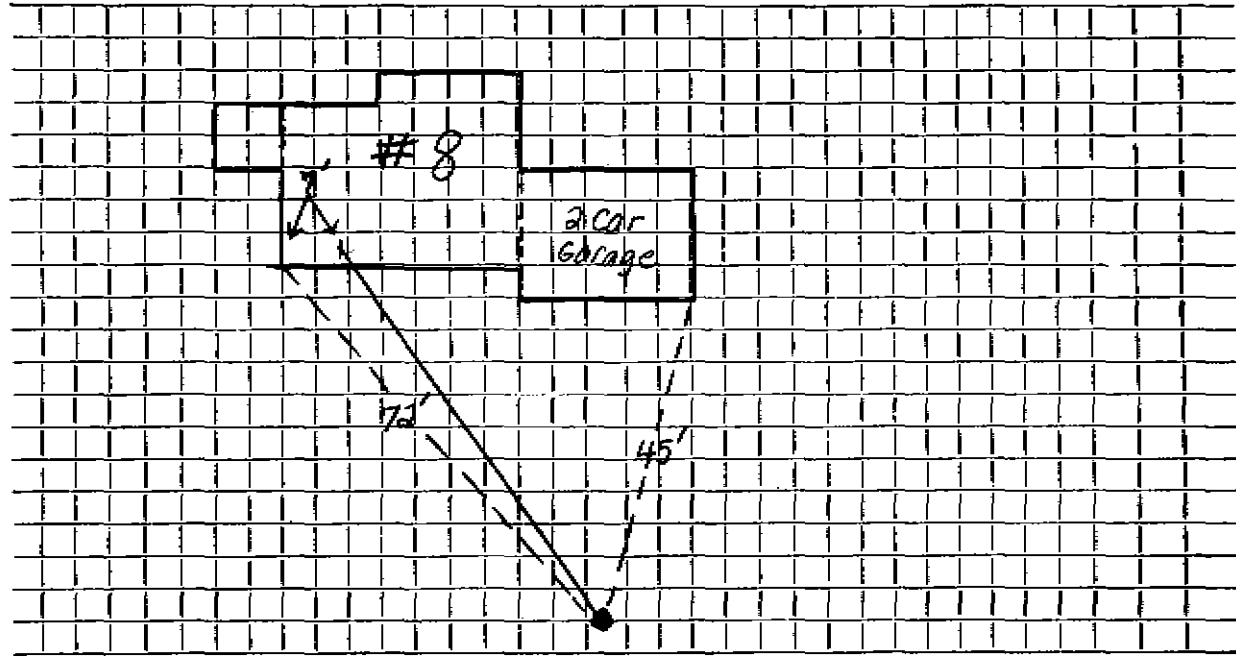

Connection made in ..... Street. Work completed .....

Remarks: ... Sewer Stub is 4' Deep .....

.....  
.....