

Name Donald Jenkins, Jr.Service No. 15Address 10 Minola RoadLot #2Location 10 Minola Rd.

Kind of Pipe

Size

Size of Main

~~Basic Service~~ New ServiceLocation Comm 5-4-59

Date	Material	Amount	Total	Date	Amount
7-30-58	Labor	6.53		4-9-59	Deposit 106.00
	10% O.H.	.65	7.18	5-4-59	* Refund 33.57
	201' 6" Transite Pipe @.70		14.00	7-30-58	66.43
	1 hr. Trucking @.75		.75		20' 6" Transite
	(bill when connected)		21.93		
4-14-59	Labor	7.73			
	10% O. H.	.77	8.50		
	42' 6" Transite Pipe @.70		29.40		
	1 11 1/2° Transite Elbow		5.10		
	2 Hrs. Trucking @.75		1.50		
			66.43		
	Labor				

* Apply 10.74 to bill C-# 35

TOWN OF LEXINGTON—DEPT. OF PUBLIC WORKS
SEWER DIVISION

DATE.....

NO.


The undersigned applies for the construction of a particular sewer connecting No.....
Street and hereby agrees to comply with the Rules and Regulations governing the construction and use of Particular
Sewers, as now or at any future time established by the Board of Selectmen.

Am't of estimate \$.....

Am't Paid \$.....

..... Owner

Sketch of Service Here

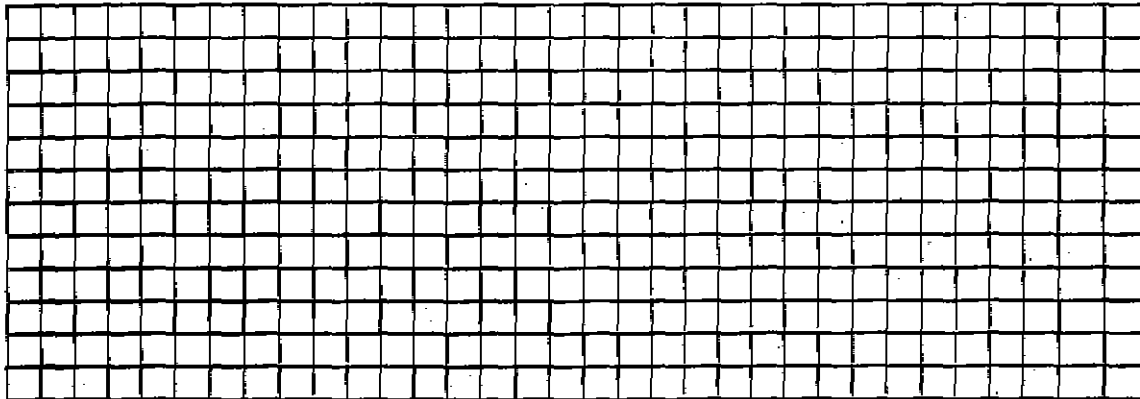

Connection made in..... Street.

Work completed..... 19..

Remarks: