

Name *A. LaFaci & Son*Service No. *148*Address *11 Minola Road*Lab # *4*Location *11 Minola Rd.*

Kind of Pipe

Size

Size of Main

~~XXXXXX~~ *New Service*Location *Conn 11/16/59*

| Date | Material | Amount | Total | Date | Amount | |
|---------|--------------------------------------|--------|-------|----------|-----------------------|-------|
| 7-30-58 | Labor | 6.53 | | 8-24-59 | Deposit | 95.00 |
| | 10% O.H. | .65 | 7.18 | 11-16-59 | * Retaind | 2.37 |
| | 20' 6" Transite pipe @.70 | | 14.00 | 7-30-58 | | 72.63 |
| | 1 hr. Trucking @.75 | | .75 | | 20' 6" TRANSITE | |
| | (bill when connected) | | 21.93 | | | |
| 8-28-59 | Labor | 12.88 | | | | |
| | 10% O. H. | 1.29 | 14.17 | 3-12-66 | Roots 65' metro sewer | |
| | 50' 6" Transite pipe @.70 | | 35.00 | | Respond + measure | |
| | 2 Hrs. Trucking @.75 | | 1.50 | | | |
| | | | 72.63 | 1-17-66 | Camera show roots | |
| 2-8-66 | 5' - 6" PVC | | | | 65' ours respond | 66 |
| | Labor | | | | if called | |
| | 2-6x6 PVC to AC | | | 2-8-66 | Repair made at | |
| | FRANCOS | | | | edge of ROAD | |
| | | | | | * Applied to UNIT 194 | |

TOWN OF LEXINGTON—DEPT. OF PUBLIC WORKS

SEWER DIVISION

DATE.....

NO.


The undersigned applies for the construction of a particular sewer connecting No.....
 Street and hereby agrees to comply with the Rules and Regulations governing the construction and use of Particular
 Sewers, as now or at any future time established by the Board of Selectmen.

Am't of estimate \$.....

Am't Paid \$.....

..... Owner

Sketch of Service Here

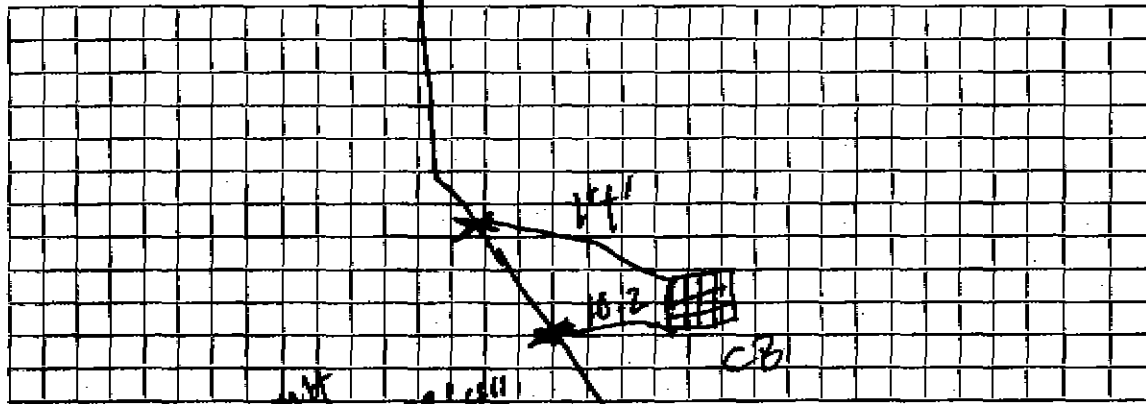

Connection made in Work completed..... 19..

Remarks:

Repair made over drain