

Name **Herman Swantz**

Service No.

Address **12 Minola Road**

Lot #3

Location **12 Minola Rd.**

Kind of Pipe

Size

Size of Main

Repair—Renewal—New Service

Redmond #0080

Location


Date	Material	Amount	Total	Date	Amount
7/30/58	Labor	6. 53		8-31-58	28.23
	10% O.H.	. 65	7. 18		
29'	6" Transite pipe @.70		20. 30	7-30-58	
1	hr. Trucking @.75		75	29' 6" Transite	
	BILL WHEN CONNECTED		28. 23		
10/10/90	32' 6" PVC				
	8' 4" PVC				
	4" x 6" Reducer				
	6" x 6" Adapter				

DATE 10-23-90

TOWN OF LEXINGTON — BOARD OF PUBLIC WORKS

SEWER DIVISION

Sketch of Service Here

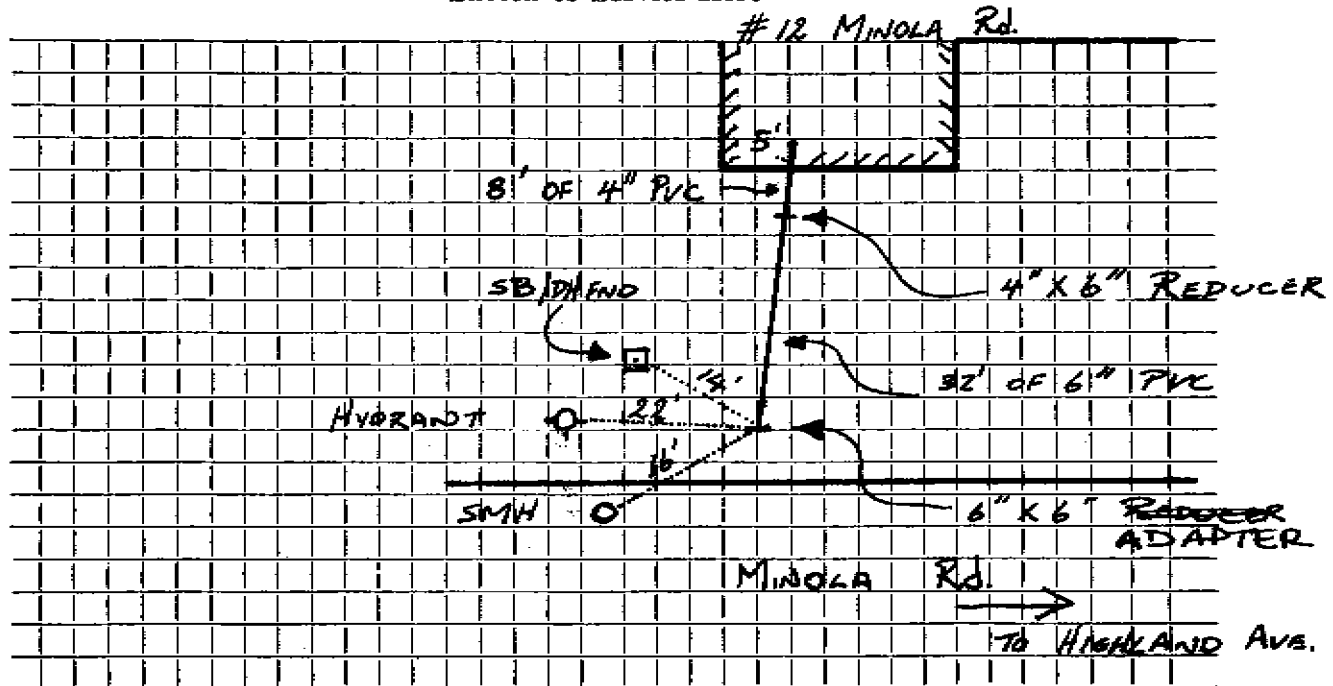

Connection made in ... MINOLA ROAD ... ~~STREET~~ Work completed

Remarks: INSPECTED ON 10-10-90 BY P. BARRADS. CONTRACTOR P. J. REDMOND

NO OUTSIDE TIES