

Name Donald Jenkins, Jr.

Service No. 205

Address 5 Minola Road

Lot #7

Location 5 Minola Rd.

Kind of Pipe

Size

Size of Main

~~XXXXXXXXXXXX~~ New Service

Location *Com 12-31-59*

Date	Material	Amount	Total	Date	Amount
7-30-58	Labor	6.53		<i>11-16-59</i>	<i>Deposit 95.00</i>
	10% O.H.	.65	7.18	<i>12-31-59</i>	<i>* Refund 6.48</i>
	<del>20' 6" Transite Pipe @.70</del>		14.00	<i>7-30-58</i>	<i>68.73</i>
	1 hr. Trucking @.75		.75		<i>20' 6" Transite</i>
	(bill when connected)		21.93		
10-20-59	Labor	13.77			
	10% O.H.	1.38	15.15		
	37' 6" Transite pipe @.70		25.90		
	1 11 1/4" Transite Bend		5.10		
	1 Hr. Trucking @.75		.75		
			68.73		
	Labor				

*\* Reply 2-59 to W.P.C. #264*

**TOWN OF LEXINGTON—DEPT. OF PUBLIC WORKS**  
**SEWER DIVISION**

DATE.....

NO.....

The undersigned applies for the construction of a particular sewer connecting No.....  
Street and hereby agrees to comply with the Rules and Regulations governing the construction and use of Particular  
Sewers, as now or at any future time established by the Board of Selectmen.


Am't of estimate \$.....

Am't Paid \$.....

..... Owner

---

**Sketch of Service Here**

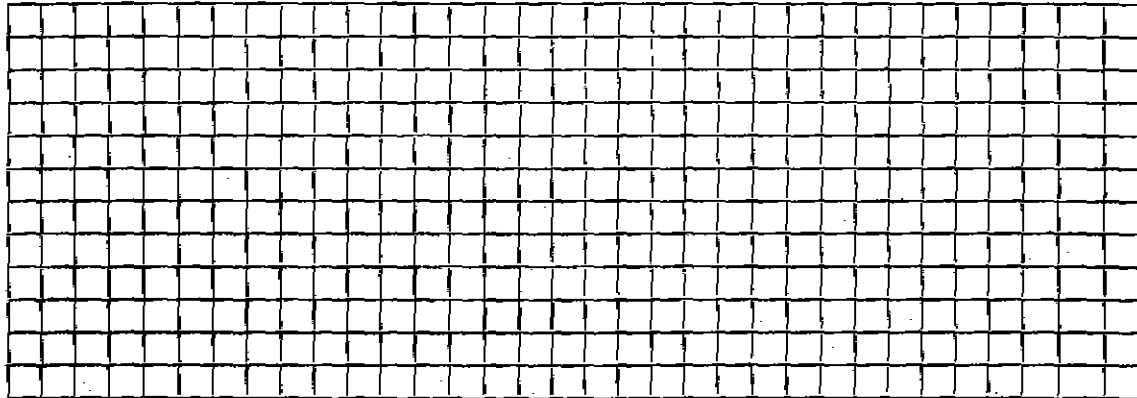

Connection made in..... Street.

Work completed.....19..

Remarks: