

Name Donald Jenkins

Service No. 10

Address 7 Minola Road

Lot #6

Location 7 Minola Rd.

Kind of Pipe

Size

Size of Main

~~XXXXXXXXXXXX~~ New Service

Location C. m. 6-9-60

Date	Material	Amount	Total	Date	Amount
7-30-58	Labor	6.53		3-21-60	Deposit 75.00
	10% O.H.	.65	7.18	6-9-60	Paid 9.76
	20' 6" Transite Pipe @.70		14.00	7-30-58	84.76
	1 hr. Trucking @.75		.75		20' 6" Transite
	(bill when connected)		21.93		
3-22-60	Labor	23.63			
	10% O.H.	2.36	25.99		
40'	6" Transite Pipe @.78		31.20		
1	22 1/2" Transite bend		2.21		
1	Duplex Adapter		1.90		
2	hr. Trucking @.75		1.50		
	Previous Charge		21.93		
	Labor		84.76		
				Bill sent 5-9-60	9.76

**TOWN OF LEXINGTON—DEPT. OF PUBLIC WORKS
SEWER DIVISION**

DATE.....

NO.


The undersigned applies for the construction of a particular sewer connecting No.....
Street and hereby agrees to comply with the Rules and Regulations governing the construction and use of Particular
Sewers, as now or at any future time established by the Board of Selectmen.

Am't of estimate \$.....

Am't Paid \$.....

..... Owner

Sketch of Service Here

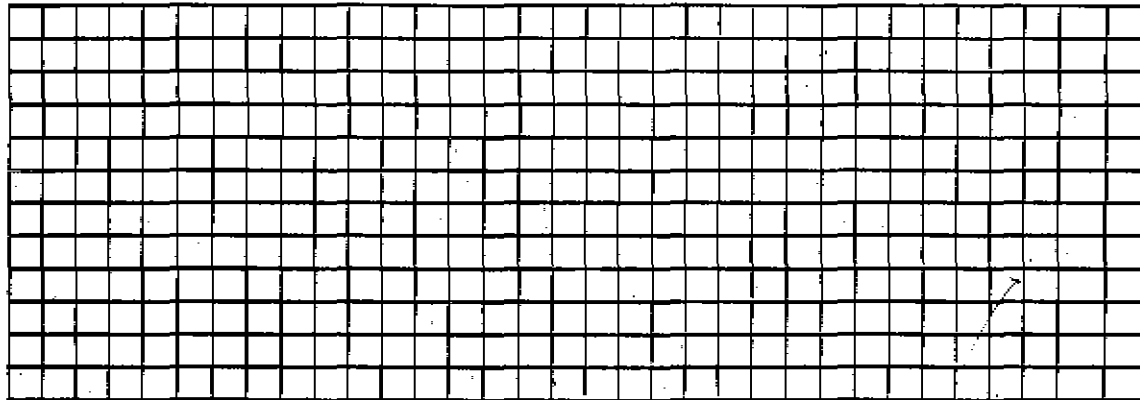

Connection made in..... Street.

Work completed..... 19..

Remarks: