

Name Walter CampbellService No. 102Address 1 Minute Man Lane1 MINUTE MAN LANE

Location

Kind of Pipe

Size

Size of Main


~~REPAIR WORK~~ New Service W.O. #8159Location Ann 10-28-63

Date	Material	Amount	Total	Date	Amount
-11-63	Labor	87.62		8-14-63	400.00
-12-63	"	80.53	168 15	10-28-63	10 93
	10% O.H.	16 82	184 97		389 07
	105' 6" Transite Pipe @.82		86 10		
	2 22 $\frac{1}{2}$ " Elbow @ 2.35		4 70		
	1 11 $\frac{1}{4}$ " Transite Bend		4 09		
	1 6" Adapter		1 62		
	1 90° Transite Elbow		4 09		
	3 hrs. Town Shovel @ 6.50		19 50		
	2 hrs. Trucking @ 3.00		6 00		
	1 hr. Loader @ 5.00		5 00		
	28 x 3 Patch		28 00		
	15 yds. Loam		45 00		
			389 07		

DATE _____

TOWN OF LEXINGTON — BOARD OF PUBLIC WORKS
SEWER DIVISION

Sketch of Service Here

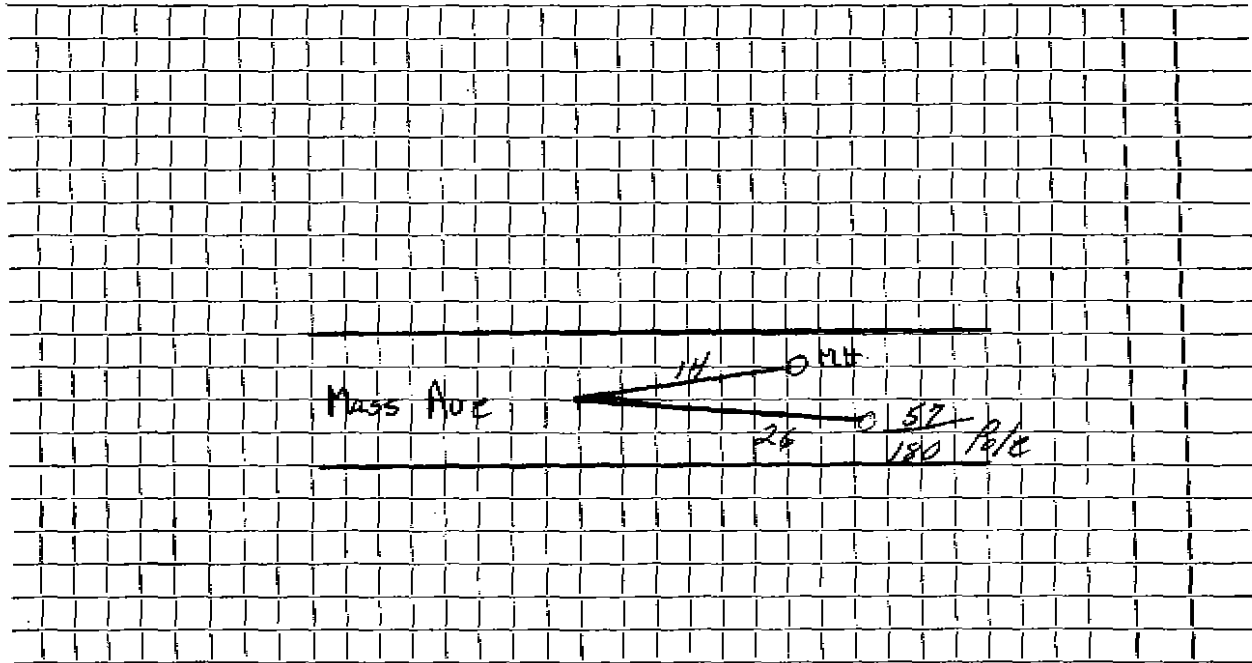

Connection made in Street. Work completed

Remarks:

.....

.....