

John D. Crane, Jr.

Service No. 130

Address 12 Minute Man Lane

12 MINUTE MAN LANE

Location

Comm. 10-28-57

Kind of Pipe

Size

Size of Main

~~REPAIRS~~ - New Service

Location

Date	Material	Amount	Total	Date	Amount
8-29-57	Labor	33.91		8-19-57	Deposit \$ 150.00
	10% O.H.	3.39	37.30	10-28-57	Refund \$ 57.80
36'	6" Transite pipe @ .70		25.20		\$ 92.20
2	6" 45° Bend Long @ 7.60		15.20		
2	hrs. Town Shovel @ 6.50		13.00		
2	hrs. Trucking @ .75		<u>1.50</u>		
			92.20		
	Labor				

**TOWN OF LEXINGTON—DEPT. OF PUBLIC WORKS**  
**SEWER DIVISION**

DATE.....

NO. ....


The undersigned applies for the construction of a particular sewer connecting No.....  
Street and hereby agrees to comply with the Rules and Regulations governing the construction and use of Particular  
Sewers, as now or at any future time established by the Board of Selectmen.

Am't of estimate \$.....

Am't Paid \$.....

..... Owner

**Sketch of Service Here**

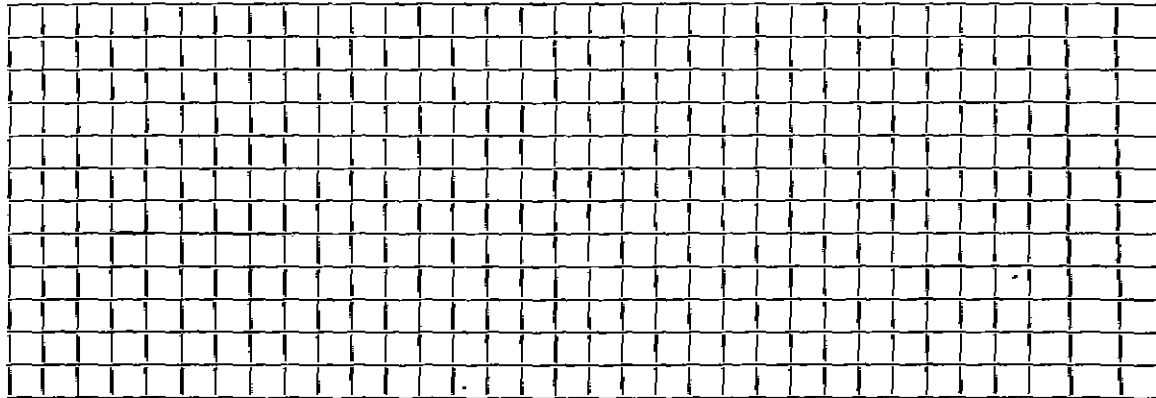

Connection made in..... Street.

Work completed.....19..

Remarks: