

Name *Walter Thompson*

Service No. 180

Address *15 Minute Man Lane*

15 Minute Man Lane

Kind of Pipe

Size

Size of Main

~~Residential~~ *New Service*

Location

Cond 1-1460

Date	Material	Amount	Total	Date	Amount
29-60	Labor	26.50		9-16-60	200.00
	10% O.H.	2.66	29.22	1-14-60	56.69
	30' 6" Transit pipe @ .78		23.40		145.31
1	1 1/2" Transit Bend		5.10		
2	hrs. Trucking @ 3.00		6.00	Labor	11.52
2	hrs. Flippin Shovel @ 4.50		9.00	NON CHARGE	
	PREVIOUS CHARGE		70.59	1 hr. Flippin Shovel @ 4.50	4.50
			143.31	(DUG WRONG PLACE)	16.02
				9-23-67	
				22' 6" Transit	
				1 6" - 1/4" Bend	
				1 6" - 1/2" Bend	
				1 6" X 8" Wye	


DATE _____

TOWN OF LEXINGTON — BOARD OF PUBLIC WORKS

SEWER DIVISION

Sketch of Service Here

15

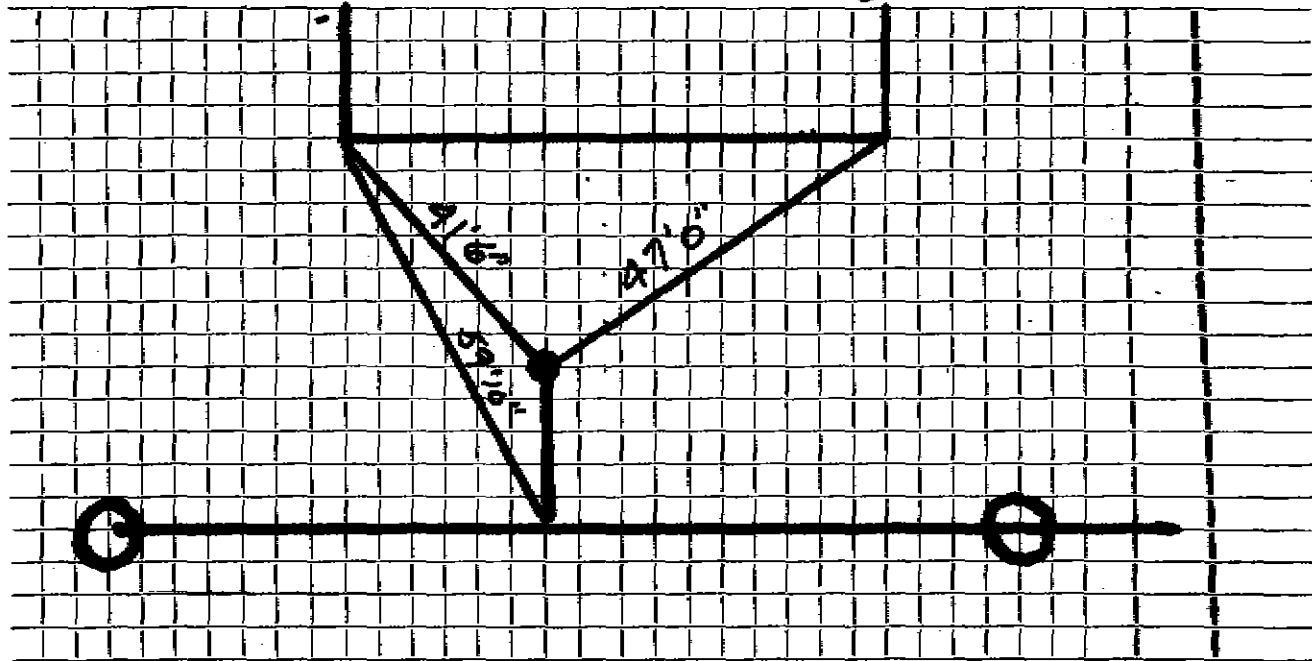

Connection made in Street. Work completed

Remarks:
.....
.....