

Name **Albert F. Orlandino**

Service No **341**

Address **18 Minute Man Lane**

**18 Minute Man Lane**

Location

*Comm. 11-18-57*

Kind of Pipe

Size

Size of Main

Repair—Renewal—New Service

Location

Date	Material	Amount	Total	Date	Amount
9/10/57	Labor	92 72		8-28-57	Deposit
	10% overhead	9 27		11-18-57	Refund
			101 99		# 200 00
	88' 6" transite pipe @.70		61 60		(12 62
	1 6" 45° elbow		2 79		# 187 38
	3 hrs. town shovel @6.50		19 50		
	2 hrs. trucking @.75		1 50		
			187 38		
	Labor				

TOWN OF LEXINGTON—DEPT. OF PUBLIC WORKS  
**SEWER DIVISION**

DATE.....

NO. ....


The undersigned applies for the construction of a particular sewer connecting No.....  
Street and hereby agrees to comply with the Rules and Regulations governing the construction and use of Particular  
Sewers, as now or at any future time established by the Board of Selectmen.

Am't of estimate \$.....

Am't Paid \$.....

..... Owner

**Sketch of Service Here**

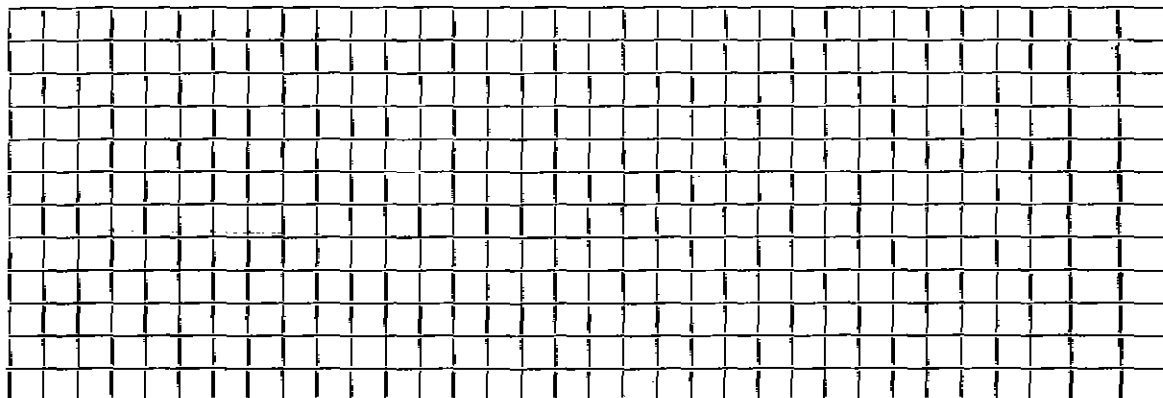

Connection made in..... Street.

Work completed..... 19..

Remarks: