

Name **H. W. Merriam**Service No. **120**Address # **21 MINUTE MAN LANE**

Location

*Comm. 10-28-57*

Kind of Pipe

Size

Size of Main

~~XXXXXX~~ New Service

Location

| Date   | Material                  | Amount | Total  | Date     | Amount  |           |
|--------|---------------------------|--------|--------|----------|---------|-----------|
| 9-6-57 | Labor                     | 60.42  |        | 8-15-57  | Deposit | \$ 150.00 |
|        | 10 % O.H.                 | 6.04   | 66.46  | 10-28-57 | Refund  | 27.76     |
|        | 47' 6" Transite Pipe @.70 |        | 32.90  |          |         | \$ 122.24 |
|        | 1 6" Clay Elbow           |        | 1.88   |          |         |           |
|        | 3 hrs. Town Shovel @ 6.50 |        | 19.50  |          |         |           |
|        | 2 hrs. Trucking @.75      |        | 1.50   |          |         |           |
|        |                           |        | 122.24 |          |         |           |
|        | Labor                     |        |        |          |         |           |

TOWN OF LEXINGTON—DEPT. OF PUBLIC WORKS

SEWER DIVISION

DATE .....

NO. ....

The undersigned applies for the construction of a particular sewer connecting No. .... Street and hereby agrees to comply with the Rules and Regulations governing the construction and use of Particular Sewers, as now or at any future time established by the Board of Selectmen.


Am't of estimate \$.....

Am't Paid \$.....

..... Owner

Sketch of Service Here

BUILDING TORN DOWN  
AUGUST 1997

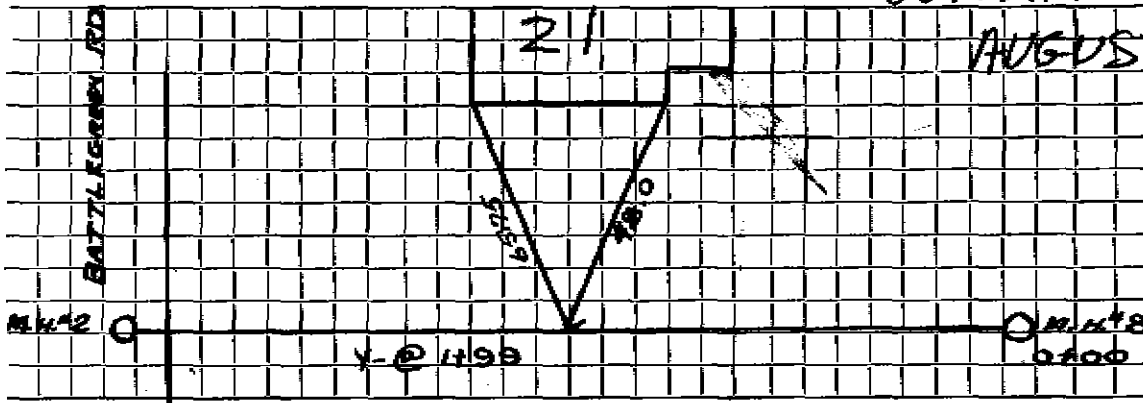

Connection made in ..... Street.

Work completed ..... 19..

Remarks: