


DATE AUGUST 28, 1997

TOWN OF LEXINGTON — BOARD OF PUBLIC WORKS

SEWER DIVISION

Sketch of Service Here

21

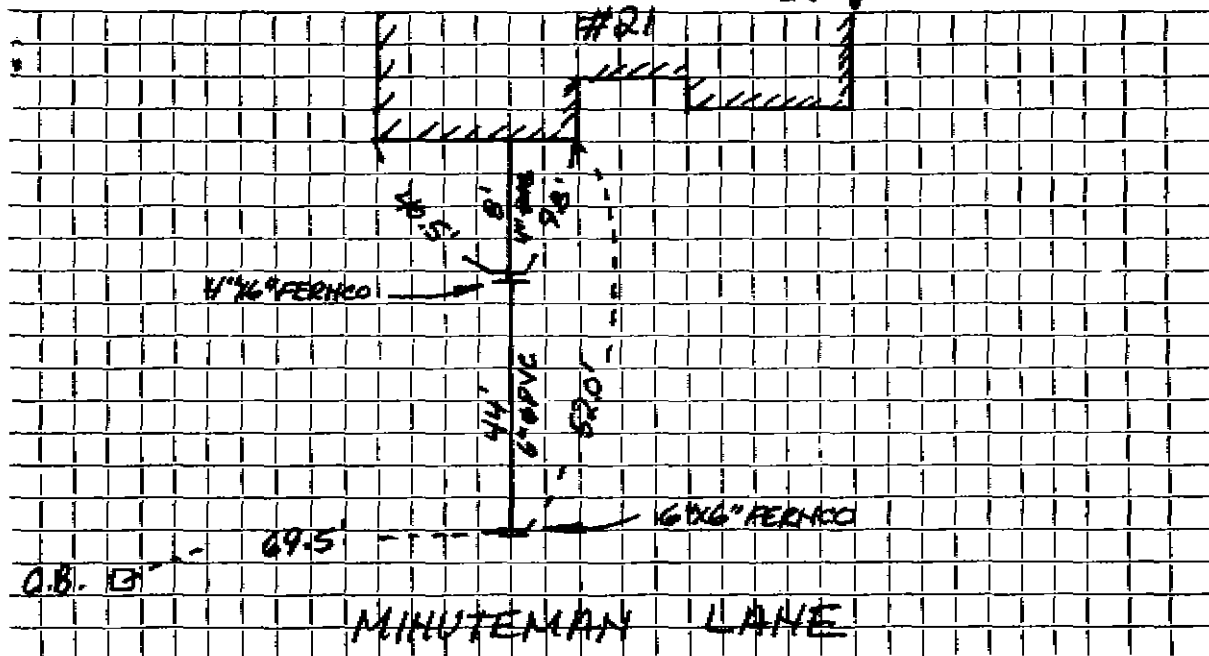

Connection made in MINUTEMAN LANE Street.

Work completed

Remarks: Original Service 9/6/57