

Name **William Gaynor**

Service No. **212**

Address **23 Minuteman Lane**
23 Minute Man Lane

Location **Comm. 12/31/57**

Kind of Pipe _____ Size _____ Size of Main _____

Repair—Renewal—New Service **SERVICE TO CURB** Location _____

Date	Material	Amount	Total	Date	Amount
1/17/57	Labor	40 52		11-12-57	Deposit
	10% overhead	4 05	44 57	5-13-58	Paid
	20' - 6" Transite Pipe @ .70		14 00		NON CHARGE
	1 hr. Shovel		6 50		
	1 hr. Hough Loader		3 00		
	2 hrs. Trucking @ .75		1 50		
			69 57		
					Northwest Shovel
					Hough Loader
					Trucking
1/10/57	Labor	51 46			
	10% overhead	5 15	56 61		
	55' 6" Transite pipe @ .70		38 50		
	3 hrs. Town Shovel @ 6.50		19 50		
	2 hr Labor Trucking @ .75		1 50		
			116 11		
	Total		185 68		Bill sent for \$35.68

TOWN OF LEXINGTON—DEPT. OF PUBLIC WORKS
SEWER DIVISION

DATE 9-17-19-57.....

NO.


The undersigned applies for the construction of a particular sewer connecting No.....
Street and hereby agrees to comply with the Rules and Regulations governing the construction and use of Particular
Sewers, as now or at any future time established by the Board of Selectmen.

Am't of estimate \$.....

Am't Paid \$.....

..... Owner

Sketch of Service Here **23**

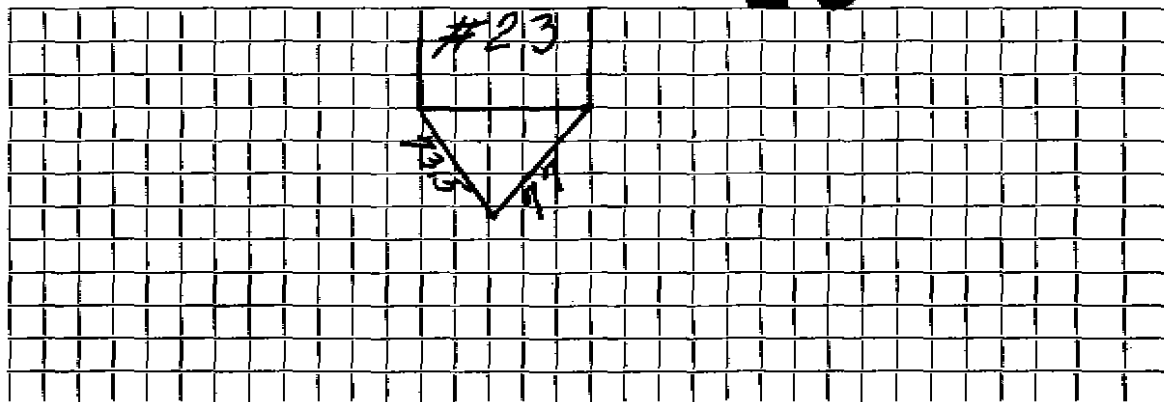

Connection made in..... Street.

Work completed.....19..

Remarks: