

Name

Diamond West Dev. Corp.

Service No.

Address

HOLDENESS @ MINUTE-MAN LANE (SUB-DIV.)

Location

Kind of Pipe PVC

Size 8"

Size of Main 8"

Repair—Removal—New Service


Cardillo #0095

Location

Date	Material	Amount	Total	Date	Amount
12/12/90	42.7 LF 8" PVC				
	2.4' INSIDE DRIP				
	1 TON CONC.				

TOWN OF LEXINGTON — BOARD OF PUBLIC WORKS  
SEWER DIVISION

Sketch of Service Here  
HOLDERNESS

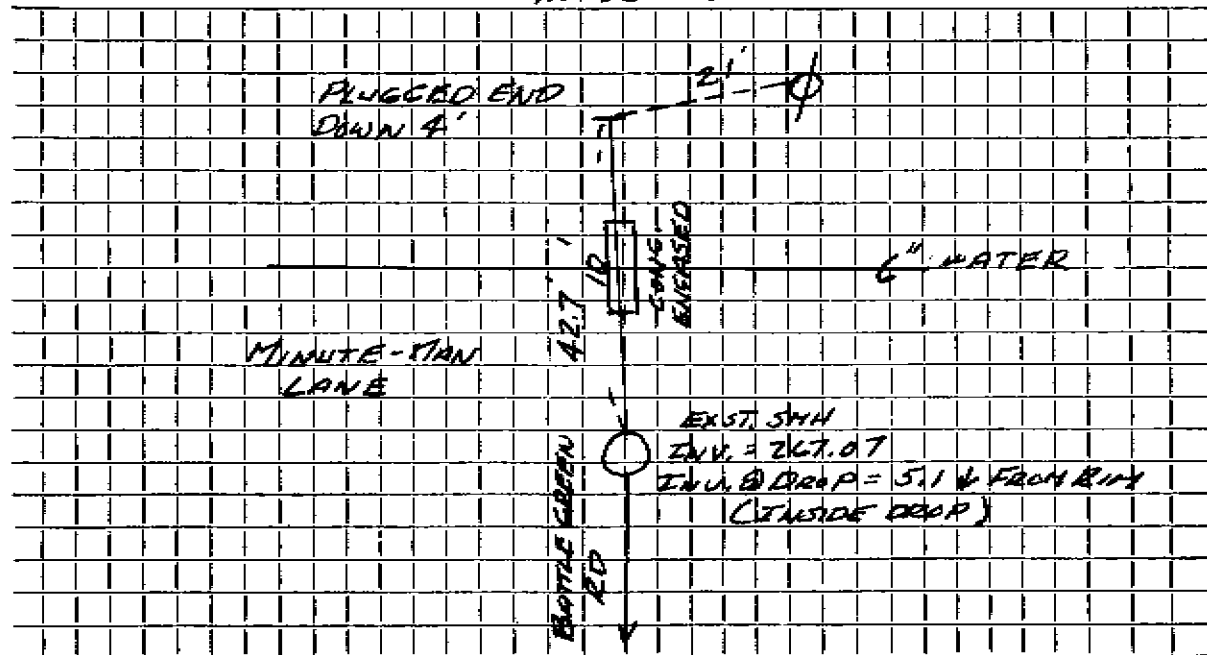

Connection made in MINUTE-MAN LANE Street. Work completed .....

Remarks: NEW MAIN TO HOLDERNESS (SUB-DIV.) 18" ABOVE EXST. WATER MAIN  
LEDGE