

Name *William Mobilia*Service No. *194*Address *3 A Minuteman Lane**3A MINUTE MAN LANE*

Location

Kind of Pipe

Size

Size of Main


~~Repair General~~ New Service *Ferrai #2389*Location *FEB 10 1975*

Date	Material	Amount	Total	Date	Amount
<i>-28-73</i>	<i>317' - 6" ACP</i> <i>10' - 4" CI</i>			<i>12-4-73</i> <i>3-11-75</i>	<i>Deposit</i> <i>Rx fund</i> <i>450.00</i> <i>302.93</i> <i>247.07</i>
<i>2-12-'73</i>	<i>Labor</i>	<i>\$138.88</i>			
	<i>10% Overhead</i>	<i>13.84</i>	<i>\$152.22</i>		
	<i>52' 6" Transite Pipe</i>		<i>51.48</i>		
	<i>1 6" Plug</i>		<i>1.77</i>		
	<i>1/2 Bag Cement</i>		<i>1.10</i>		
	<i>3 Ton Hot Top @8.00</i>		<i>24.00</i>		
	<i>2 Hrs. Trucking @3.00</i>		<i>6.00</i>		
	<i>1 Hr. Town Shovel</i>		<i>6.50</i>		
	<i>1 Hr. Loader</i>		<i>4.00</i>		
			<i>\$247.07</i>		

TOWN OF LEXINGTON — BOARD OF PUBLIC WORKS
DATE _____

SEWER DIVISION
#3A
SILVER BRIDGE BRIDGE
LAND
25'

3A

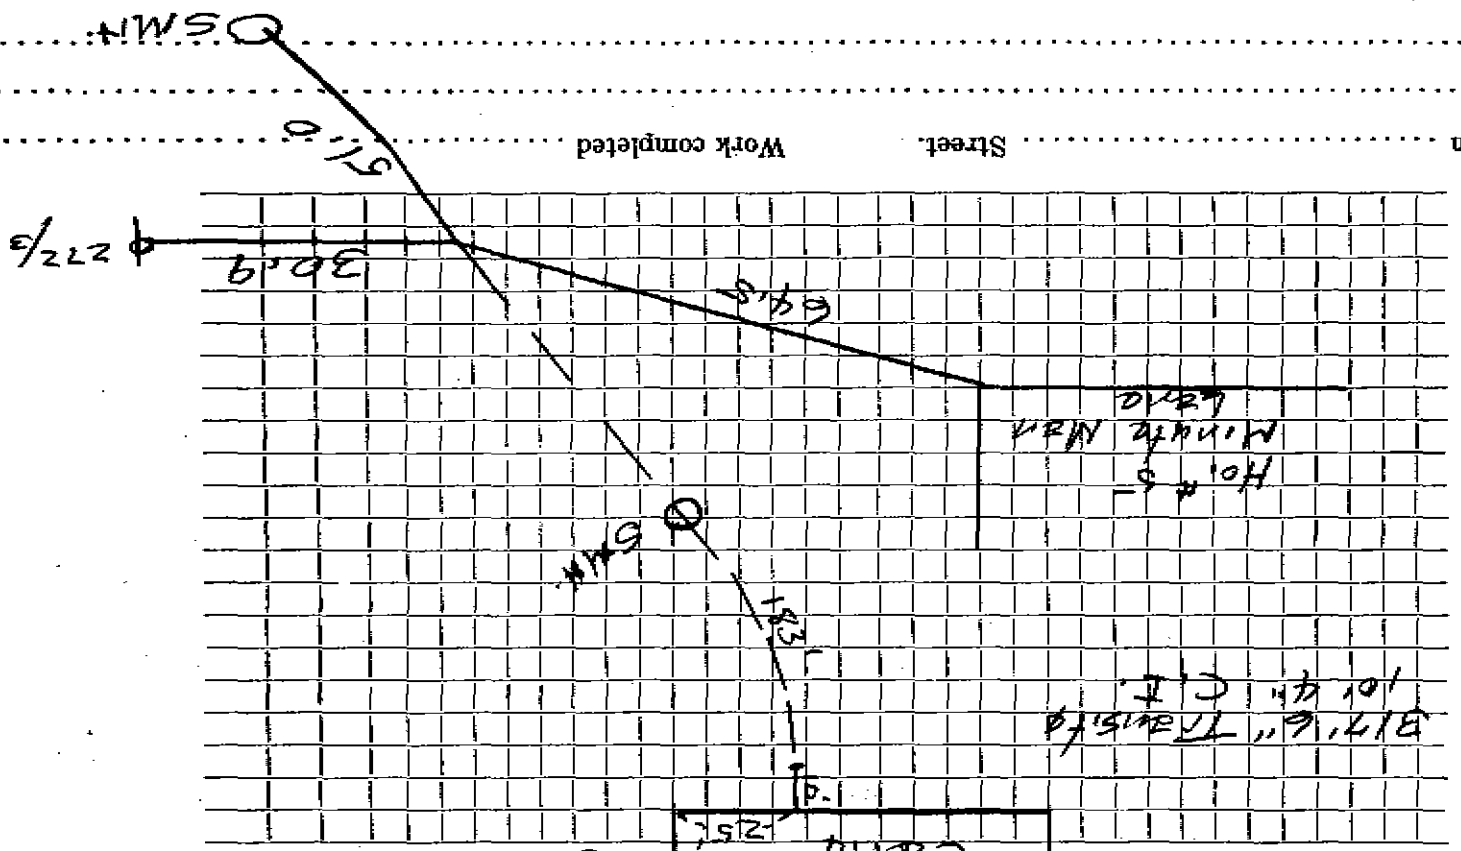

Connection made in _____ Street. Work completed _____

Remarks: _____