

Name James F. Flynn

Service No. 126

Address 3 Minuteman Lane

3 MINUTE MAN LANE

Location

Com'n. 11-18-57

Kind of Pipe

Size

Size of Main

Repair—Renewal—New Service

Location

Date	Material	Amount	Total	Date	Amount
8/27/57	Labor	117 11		8-16-57	Deposit
8/28/57	"	23 40		11-18-57	Refund
		140 51			\$ 250 00
	10% overhead	14 05	154 56		5 14
	49' - 6" Transite pipe @ .70		34 30		\$ 244 86
	1 Gaspool cover & frame		10 50		
	22 sticks Dynamite @ .25		5 50		
	10 blasting caps @ .1775		1 78		
	50 brick @ \$38/1000		1 90		
	1 bag cement		1 32		
	4 hrs. Town Shovel @ 6.50		26 00		
	4 hrs. Trucking @ .75		3 00		
	2 hrs. box compressor @ 3.00		6 00		
			244 86		

Respond to 1 blockage

Free - measure-report

RES.

6/15/83

TOWN OF LEXINGTON—DEPT. OF PUBLIC WORKS  
**SEWER DIVISION**

DATE.....

NO.....


The undersigned applies for the construction of a particular sewer connecting No.....  
Street and hereby agrees to comply with the Rules and Regulations governing the construction and use of Particular  
Sewers, as now or at any future time established by the Board of Selectmen.

Am't of estimate \$.....

Am't Paid \$.....

..... Owner

Sketch of Service Here **3**

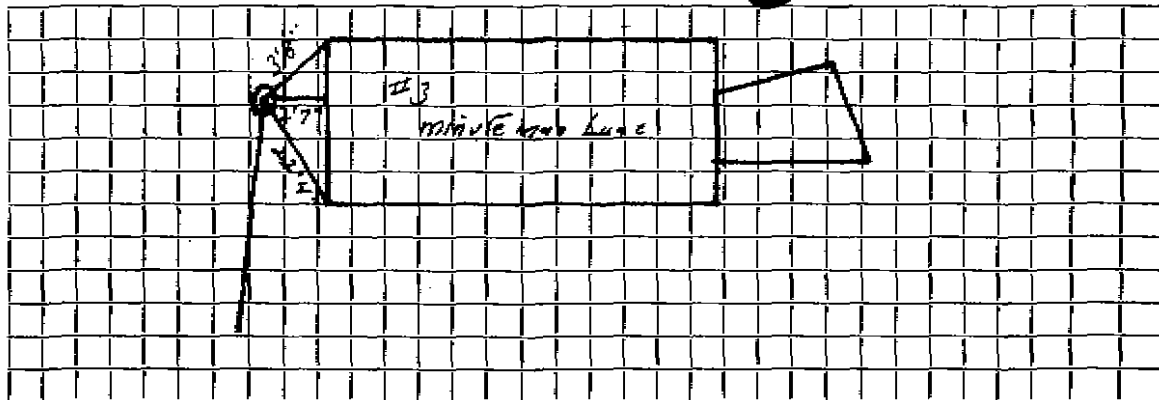

Connection made in:..... Street.

Work completed..... 19..

Remarks: