

Name **R. Bentley**

Service No. **117**

Address **6 MINUTE MAN LANE**

6 Minute Man Lane

Location

Comm. 10-28-57

Kind of Pipe

Size

Size of Main

~~XXXXXXXXXX~~ **New Service**

Location

Date	Material	Amount	Total	Date	Amount	
8-30-57	Labor	63.40		8-24-57	Deposit	250.00
	10% O.H.	6.34	69.74	10-28-57	Refund	75.09
	102' 6" Transite @.70		71.40			<u>174.91</u>
	1 bag cement		1.32			
	1 cesspool cover & frame		10.50			
	25 Bricks @ \$38.00 per 1000		.95			
	3 hrs. town shovel @ 6.50		19.50			
	2 hrs. trucking @ .75		1.50			
			174.91			
	Labor					

TOWN OF LEXINGTON—DEPT. OF PUBLIC WORKS

SEWER DIVISION

DATE.....

NO.


The undersigned applies for the construction of a particular sewer connecting No.....
 Street and hereby agrees to comply with the Rules and Regulations governing the construction and use of Particular
 Sewers, as now or at any future time established by the Board of Selectmen.

Am't of estimate \$.....

Am't Paid \$.....

..... Owner

Sketch of Service Here

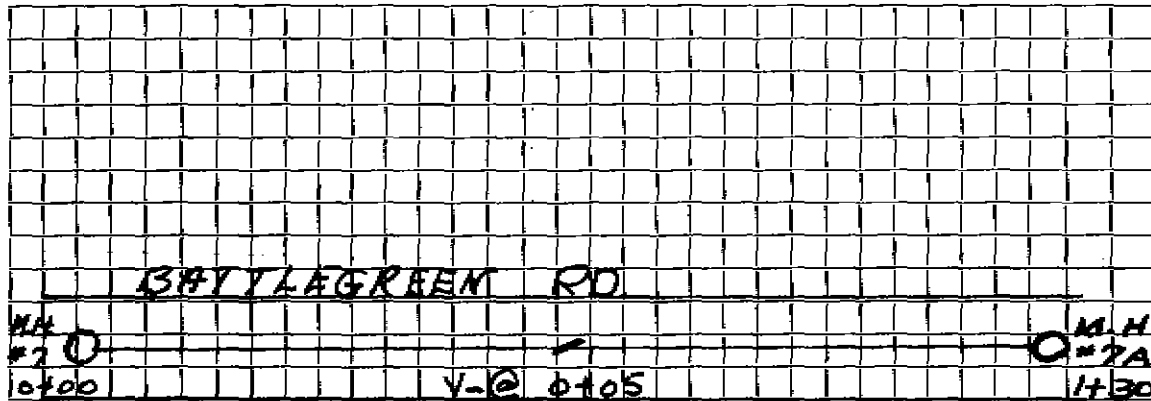

Connection made in..... Street. Work completed..... 19..

Remarks: