

Name Mrs. Doris Maggioli

Service No. 129

Address \* 7 MINUTE MAN LANE, Lexington, Mass.

7 Minute Man Lane

Location

Comm. 10-28-57

Kind of Pipe

Size

Size of Main

~~Special Transit~~—New Service

Location

Date	Material	Amount	Total	Date		Amount
9/17/18/19/20/57	Labor	99 22		8-19-57	Deposit	\$ 250 00
	10% overhead	9 92	109 14	10-20-57	Paid	25 71
	110'-6" Transite @ .70		77 00			272 71
	1-6" Long bend		6 21		NON CHARGE	
	600 Sewer Brick @ .38/1000		22 80		Labor	162 50 ✓
	8 Bags Cement @ 1.32		10 56		Insurance & other items	65 76
	1 Ton Sand		1 00		Hough loader	37 00 ✓
	2 Caspools Covers & Frames @ 10.50		21 00		Northwest Shovel	17 00 ✓
	1 hr. Hough Loader @ 3.00		3 00		Trucking	36 00
	2 hrs. Northwest Shovel @ 6.50		13 00		Compressor	3 00
	4 hrs. Trucking @ .75		3 00			
	2 hrs. Compressor @ 3.00		6 00			321 26
	Labor		272 71			
					Bill sent 10-30-57	
					\$ 22.71	

# TOWN OF LEXINGTON—DEPT. OF PUBLIC WORKS

## SEWER DIVISION

DATE .....

NO. ....


The undersigned applies for the construction of a particular sewer connecting No. ....  
 Street and hereby agrees to comply with the Rules and Regulations governing the construction and use of Particular  
 Sewers, as now or at any future time established by the Board of Selectmen.

Am't of estimate \$.....

Am't Paid \$.....

..... Owner

### Sketch of Service Here

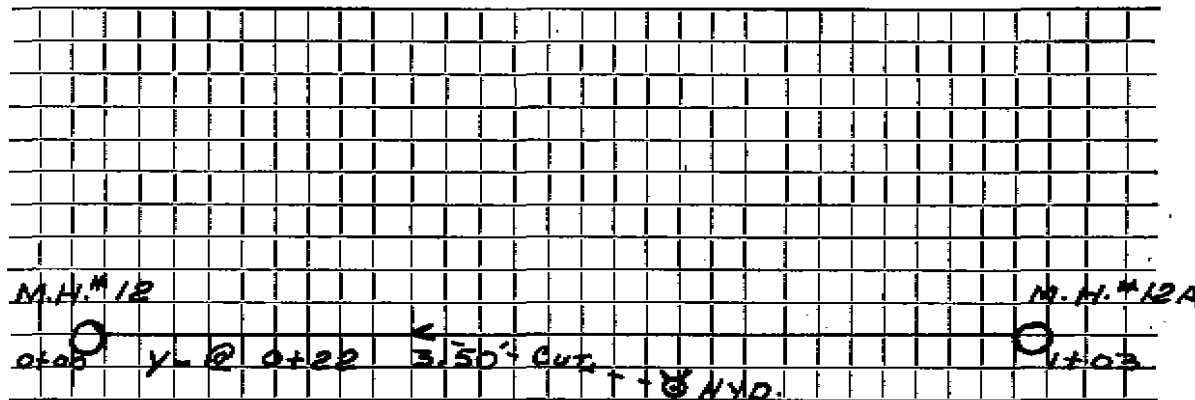

Connection made in ..... Street.

Work completed ..... 19..

Remarks: