


DATE Nov 1964

TOWN OF LEXINGTON — BOARD OF PUBLIC WORKS

SEWER DIVISION

Sketch of Service Here

3 Mohawk **3**

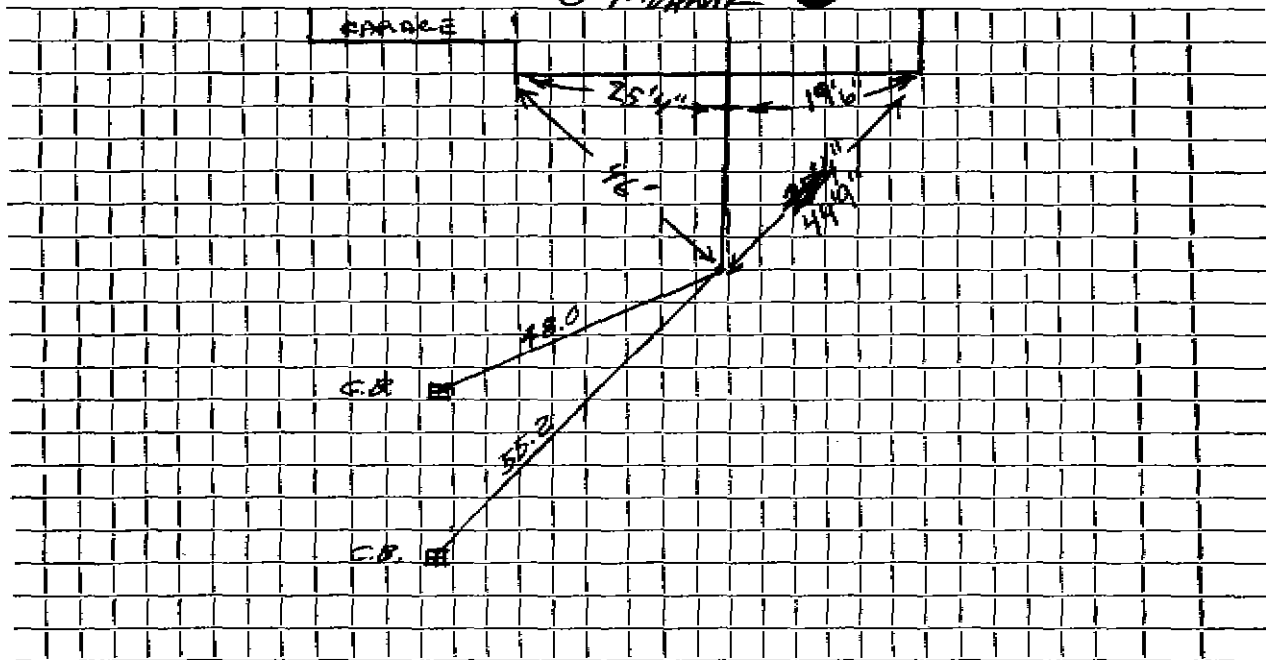

Connection made in MOHAWK DR Street. Work completed OCT 3, 1983

Remarks: WATER & SEWER SERVICE IN SAME TRENCH FROM MAIN TO EDGE OF ROAD