

Name Gleason Realty Trust

Service No.

Address 4 Mohawk Dr.

Location

4 Mohawk Dr.

Kind of Pipe

Size 6"

Size of Main 8"

~~Repair - Removl~~ New Service

Lucente #1096  
J.M. Lucete

Permit #101

Location


Date	Material	Amount	Total	Date	Amount
<del>7-164</del>	<del>35' 6" Transite pipe</del>				
8-68	139' 6" Transite pipe				
	10' 4" Cast Iron pipe				
				11- -64	
				35' 6" Transite	
				1 6" X 8" Wye	

DATE \_\_\_\_\_

TOWN OF LEXINGTON — BOARD OF PUBLIC WORKS

SEWER DIVISION

Sketch of Service Here **4**

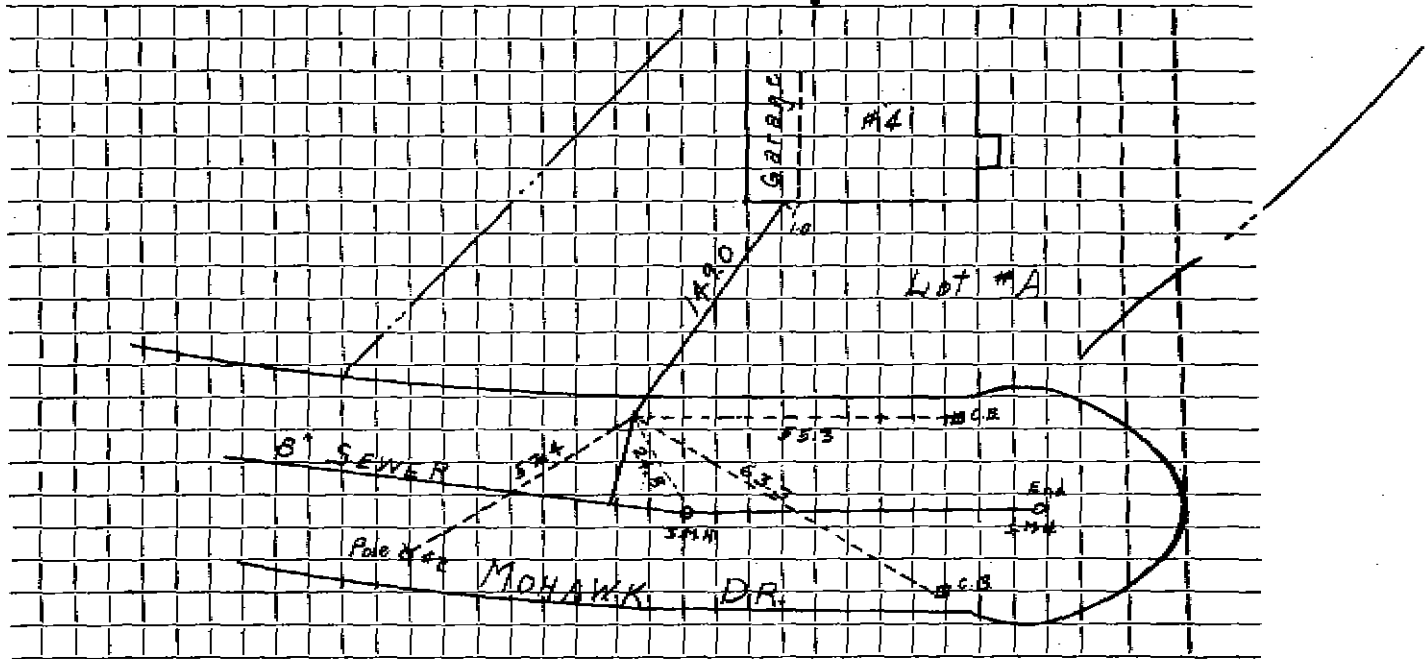

Connection made in ..... Street. Work completed .....

Remarks: .....

.....  
.....