

Name Gleason Realty Trust

Service No.

Address 5 Mohawk Drive

5 Mohawk Drive

Location

Kind of Pipe

Size **6"**Size of Main **8"**~~Repair~~ ~~Network~~ New Service J.M.Lucente Permit #102 - *2360

Location

Date	Material	Amount	Total	Date	Amount
4-16-64	58' 6" Transite pipe				
5-73	45' - 6" ACP 10' - 4" CI			11- - 69	
				58' 6" Transite 1 6" X 8" Wye	


DATE _____

TOWN OF LEXINGTON — BOARD OF PUBLIC WORKS

SEWER DIVISION

Sketch of Service Here

5

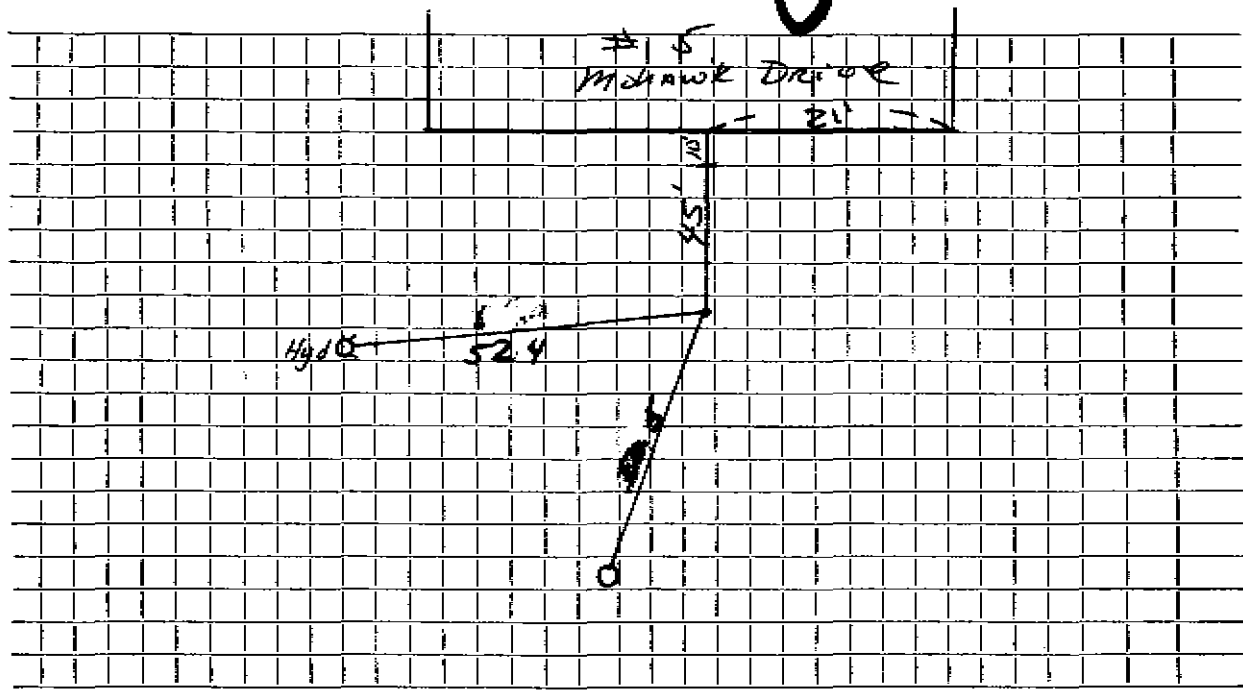

Connection made in Street. Work completed

Remarks:
.....
.....