

Service No.

1 Moonhill Rd.

Location

Kind of Pipe *AS*

Size 6"

Size of Main 8"

Repair—Renewal—New Service

Location


Date	Material	Amount	Total	Date	Location	Amount
<del>10-27-78</del>	<del>AS</del>	\$ 19.00	\$ 342.00			
				10-27-78		
				18'	6" TRANSITE	
				1	6" X 8" Tee	

TOWN OF LEXINGTON — BOARD OF PUBLIC WORKS

SEWER DIVISION

DATE \_\_\_\_\_

Sketch of Service Here

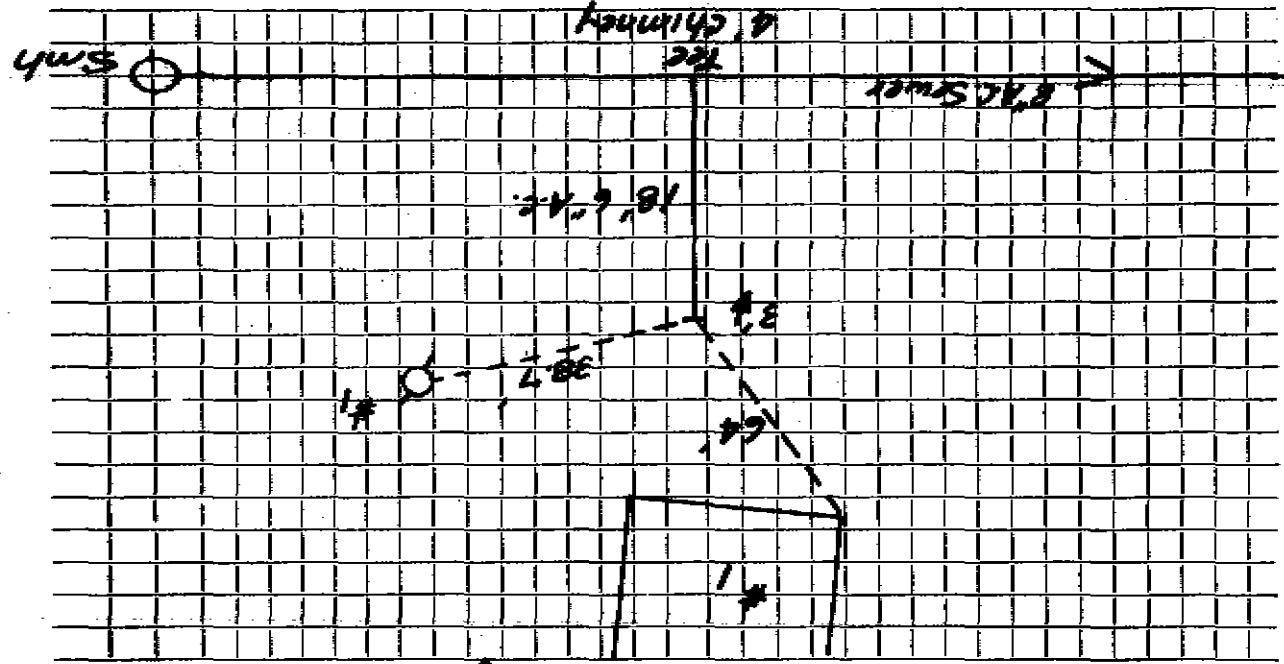

Work completed

Street

Connection made in

Remarks: