

Name

Service No. 84

Address 10 MOONHILL RD.

Location

Kind of Pipe


Size 6" PVC, 4" PVC, 2" SCH 80 AC Size of Main 8" AC

Repair—Removal—New Service THE BACK OF HOE AND EAST. CARRYING BACK w/ GALVANIZED PIPE. Location JAN 19, 1981 @ 6/20/80

Date	Material	Amount	Total	Date	Deposit	Amount
2/20/80				12-19-80		304. ⁰⁰
102'	6" PVC PIPE			12/30/80	16' 6" A.C. PIPE	
2	22° BENDS			1	6" X 8" WYE	
10'	4" CAST IRON					
1	4" CLEANOUT					
6/28/80	4" PVC w/ 4" CLEANOUT					
(2) 45° BENDS						
1	GASOLINE PUMP w/ ELECTRIC ALARM CONTROL PANEL					
	SCH 80 2" PVC					
	1 45° BEND TO MINIMIZE					
	MANHOLE					

TOWN OF LEXINGTON — BOARD OF PUBLIC WORKS
SEWER DIVISION

Sketch of Service Here

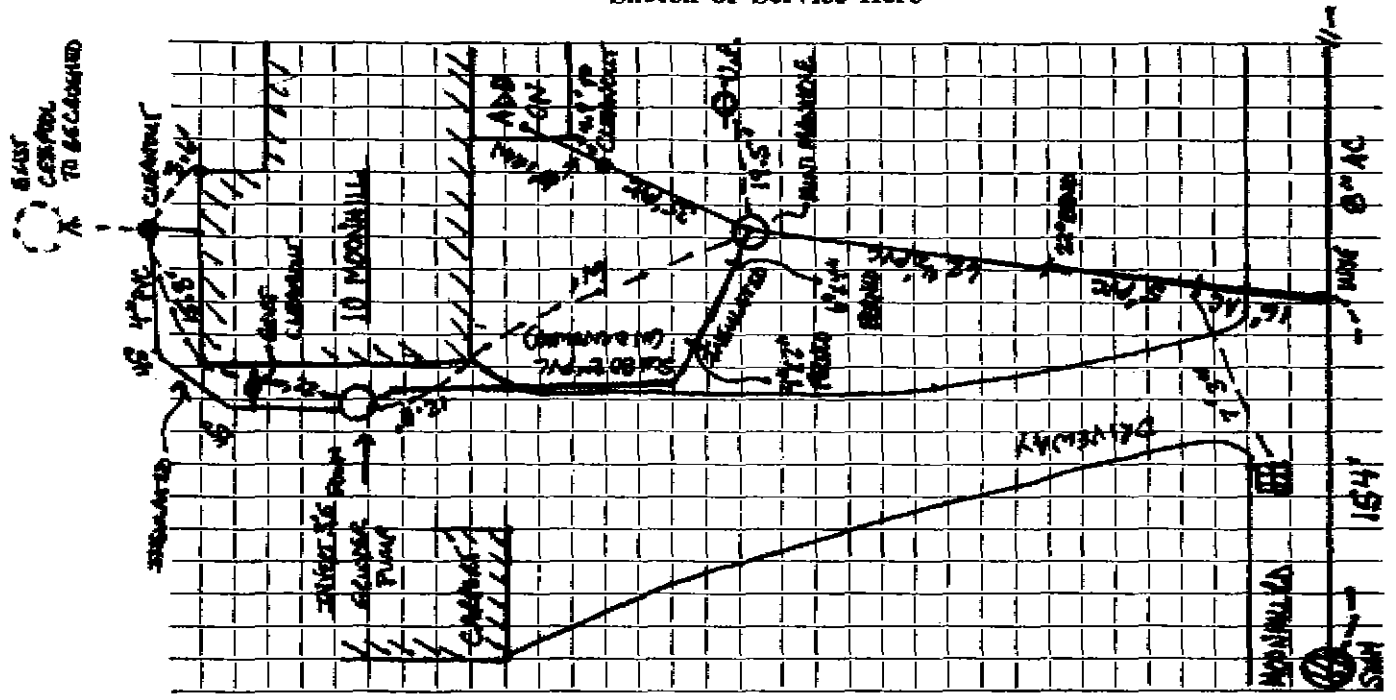

Connection made in _____ Street. Work completed _____

Remarks: GLIDER PUMP INSTALLED IN JUNE 2000 BY ARLET CO. / KIRKLAND & SONS TO PICK UP BACK PORTION OF
HOME WHICH WAS SEPARATELY TIED INTO CERAPOL. GLIDER PUMP GOES TO MANHOLE WHERE EXISTING FEED FOR FRONT OF
HOME GOES GRAVITY SEWER TO EXIST 8" MAIN ON MOONHILL RD.