


DATE 7 OCTOBER 1996

TOWN OF LEXINGTON — BOARD OF PUBLIC WORKS
SEWER DIVISION

Sketch of Service Here

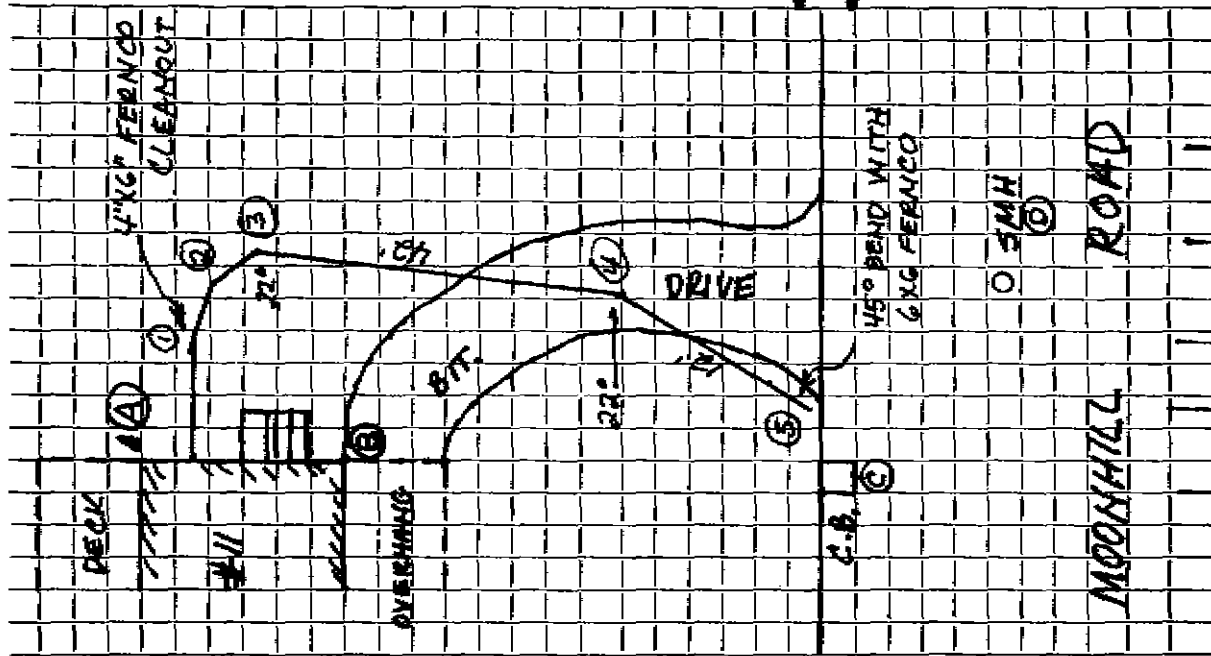

	A	B	C	D
1	15'	22'		
2	16'-6"	29'		
3	28'-6"	26'		
4			22'	40'
5			13'	30'

Connection made in MOONHILL ROAD Street.

Work completed ARLEX OIL COMPANY

Remarks: