

Name

Service No.

Account # 12 Moonhill Rd.

12 Moon Hill Rd.

Location

Kind of Pipe A.C.

Size 6"

Size of Main 8"

Repair—Renewal—New Service

Location

Date	Material	Amount	Total	Date	Amount
8-7-78	23' 6" A.C.P @	\$19.00	\$437.00	8-7-78	
	23' 6" TRANSITE			23'	
	1 6" X 8" Wye			1 6" X 8" Wye	


DATE _____

TOWN OF LEXINGTON — BOARD OF PUBLIC WORKS

SEWER DIVISION

Sketch of Service Here

12

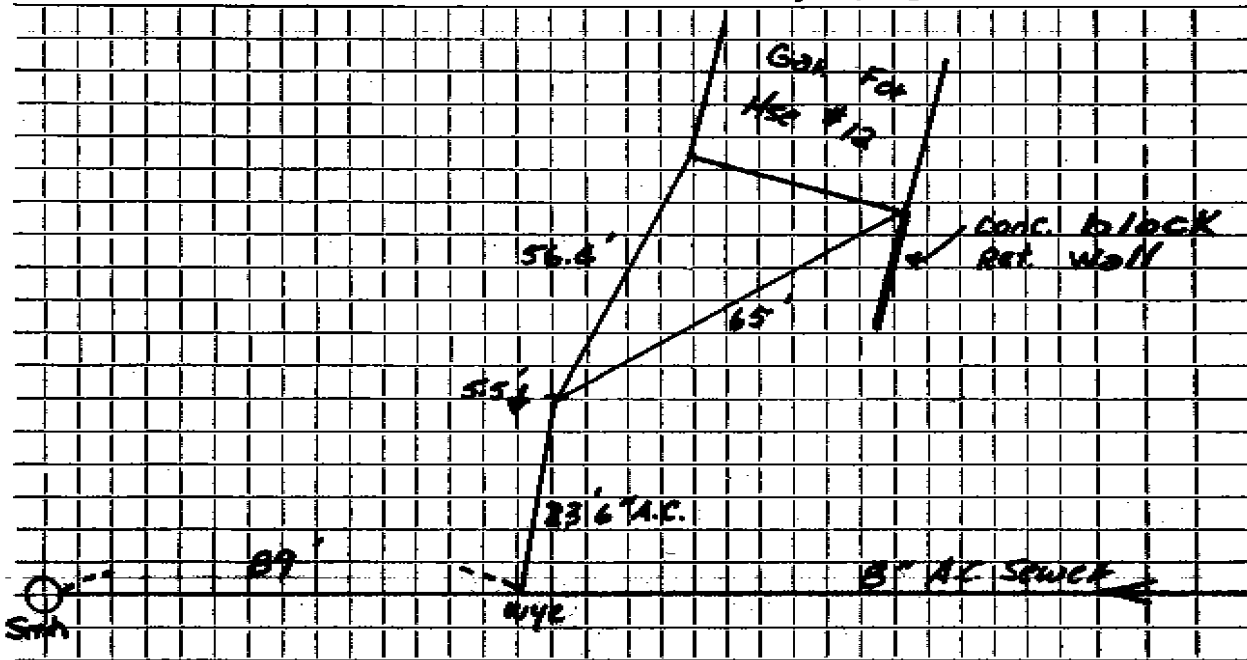

Connection made in Street. Work completed

Remarks:

.....

.....