




DATE 7/25/00

TOWN OF LEXINGTON — BOARD OF PUBLIC WORKS

SEWER DIVISION

Sketch of Service Here

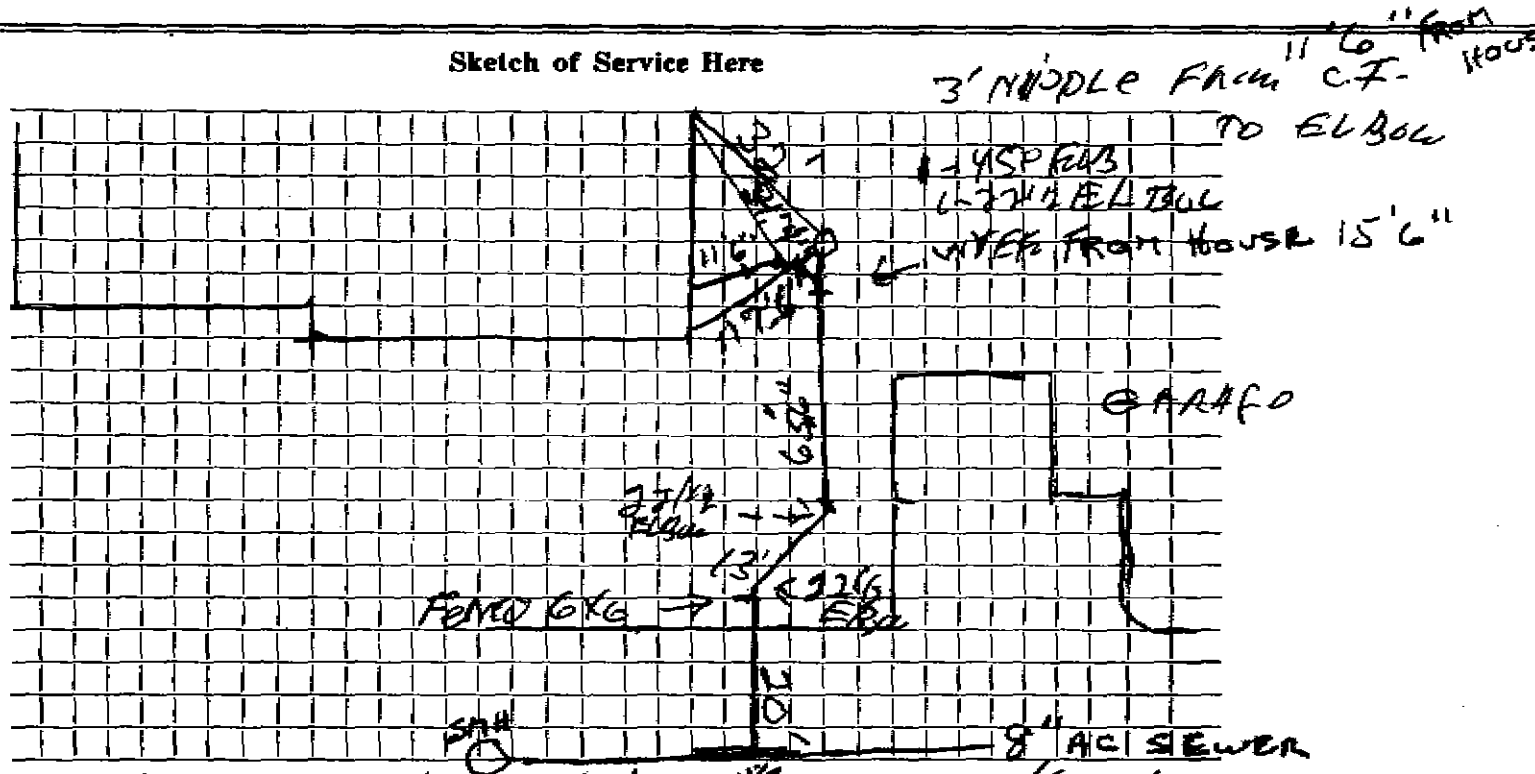

Connection made in MOON HILL Rd. Street. 31' WYE Work completed 7/25/00

Remarks: 11'6" FROM HOUSE TO 4" FRANCO ON IRON.

WYE 15'6" FROM HOUSE.