

Service No.

Name #17 Meachill Rd.

17 Moon Hill Rd.

Location

Kind of Pipe A.C.

Size 6"

Size of Main 8"

Repair—Renewal—New Service

Location


Date	Material	Amount	Total	Date	Amount
8-9-78	6" A.C.P @	\$ 19. 00	\$ 380 00	8-9-78	
				20	6" Transit
				/	6" X 8" Wye

DATE _____

TOWN OF LEXINGTON — BOARD OF PUBLIC WORKS

SEWER DIVISION

Sketch of Service Here **17**

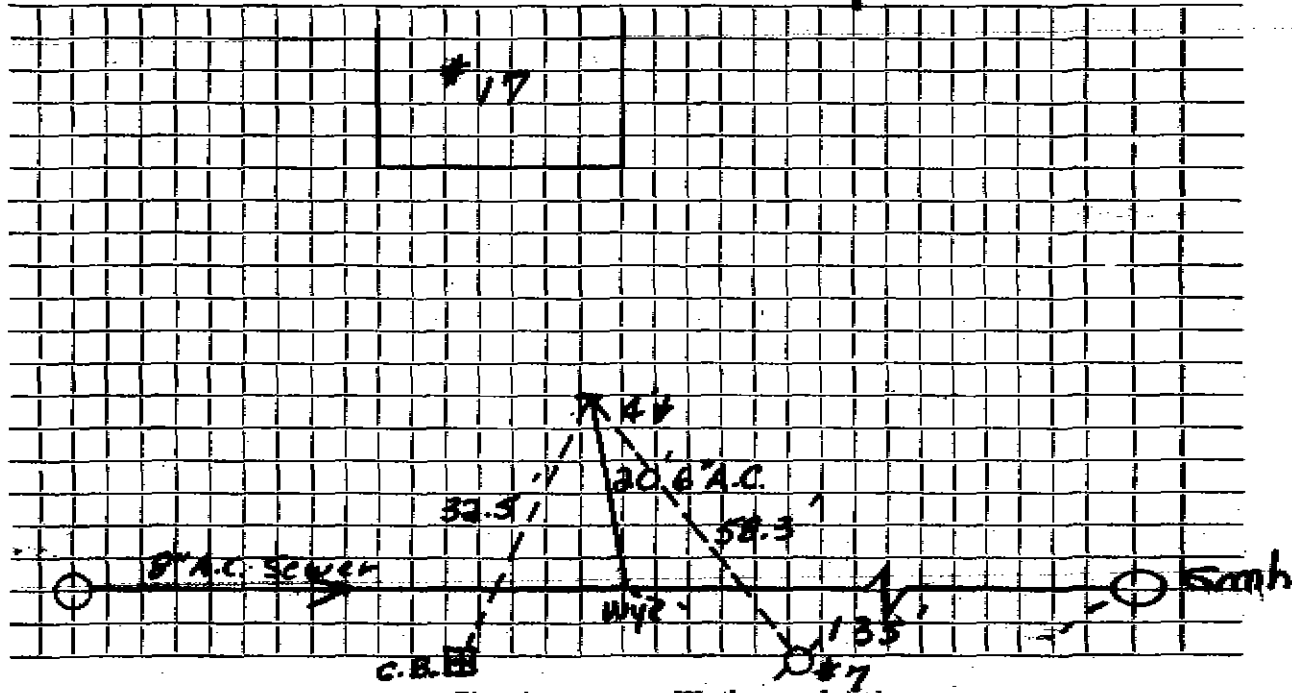

Connection made in Street. Work completed

Remarks:

.....

.....