

TOWN OF LEXINGTON — BOARD OF PUBLIC WORKS


SEWER DIVISION

DATE _____

Sketch of Service Here

25

House on
Top of Hill

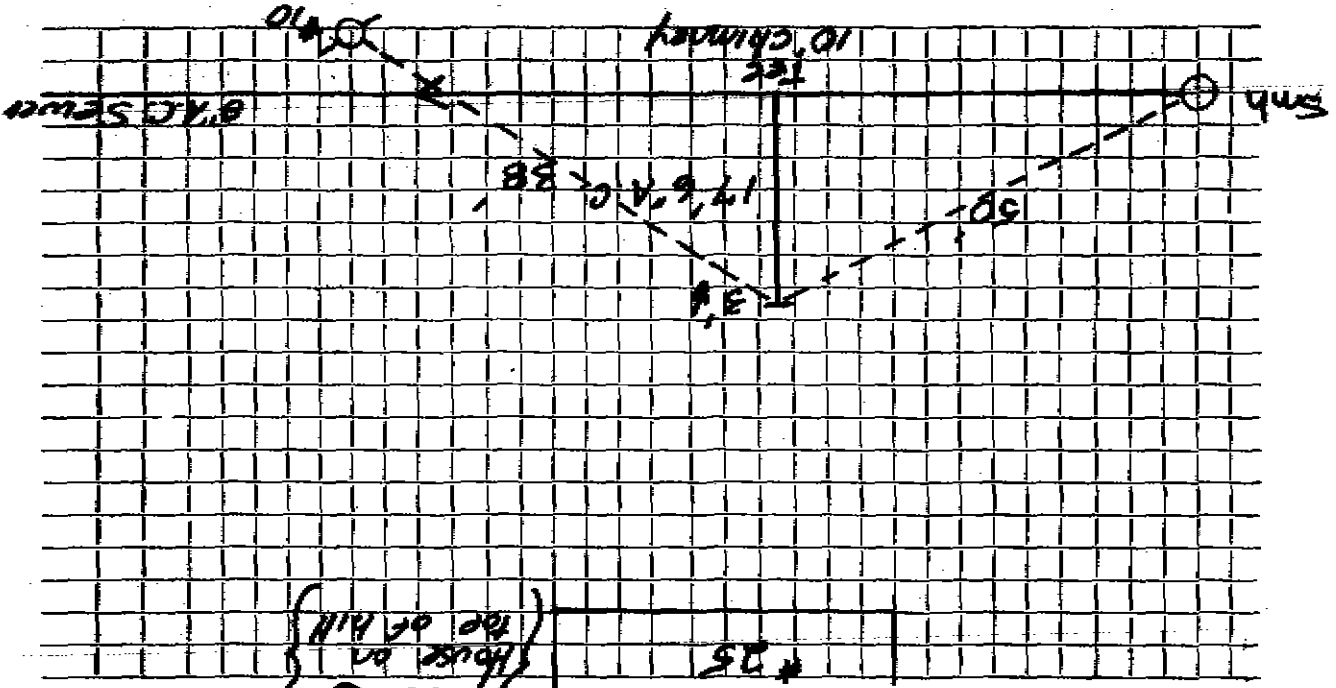

Work completed

Street.

Connection made in

Remarks: