

Service No.

28 Moorhill Rd.

28 Meen Mill Rd.

Location

Kind of Pipe A.C.

Size 6"

Size of Main 8"

Repair—Renewal—New Service

Location

Date	Material	Amount	Total	Date	Location	Amount
8-24-78	12' 6" A.C.P. @	\$19.00	\$228.00	8-24-78	12' 6" TRANSITE	
					1 6" X 8" WYE	


DATE _____

TOWN OF LEXINGTON — BOARD OF PUBLIC WORKS

SEWER DIVISION

Sketch of Service Here

28

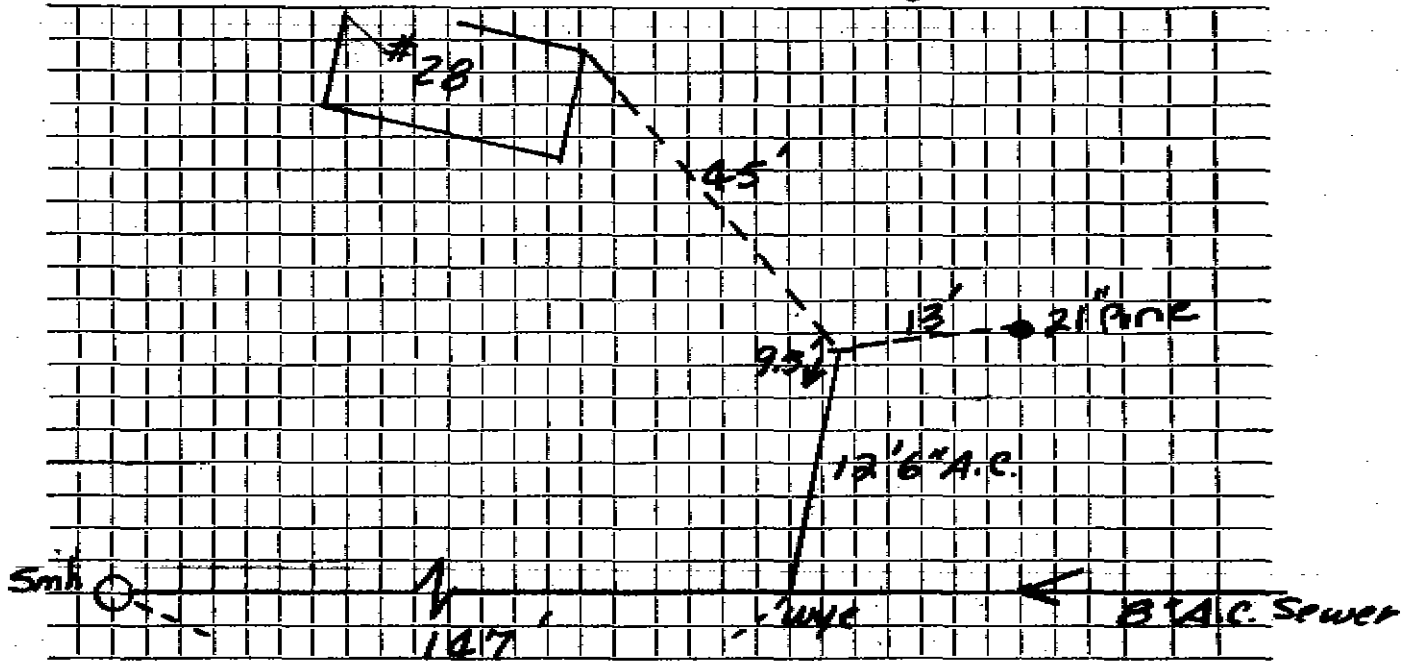

Connection made in Street. Work completed

Remarks:

.....

.....