

Service No.

Address # 29 Moonhill Rd.

29 Moon Hill Rd.

Location

Kind of Pipe A.C.

Size 6"

Size of Main 8"


Repair—Renewal—New Service

Location

Date	Material	Amount	Total	Date	Amount
6-10-95	25' C.A.C.P. @	\$ 19.00	\$ 475.00		
6-10-95	186' 6" P.V.C.			8-23-78	
/	S.M.H.			25' 6" TRANSITE	
/	CLEANOUT				
/	6" X 6" FERRO				

BRAKE
MOONHILL RD
MA

BY
BROS. INC

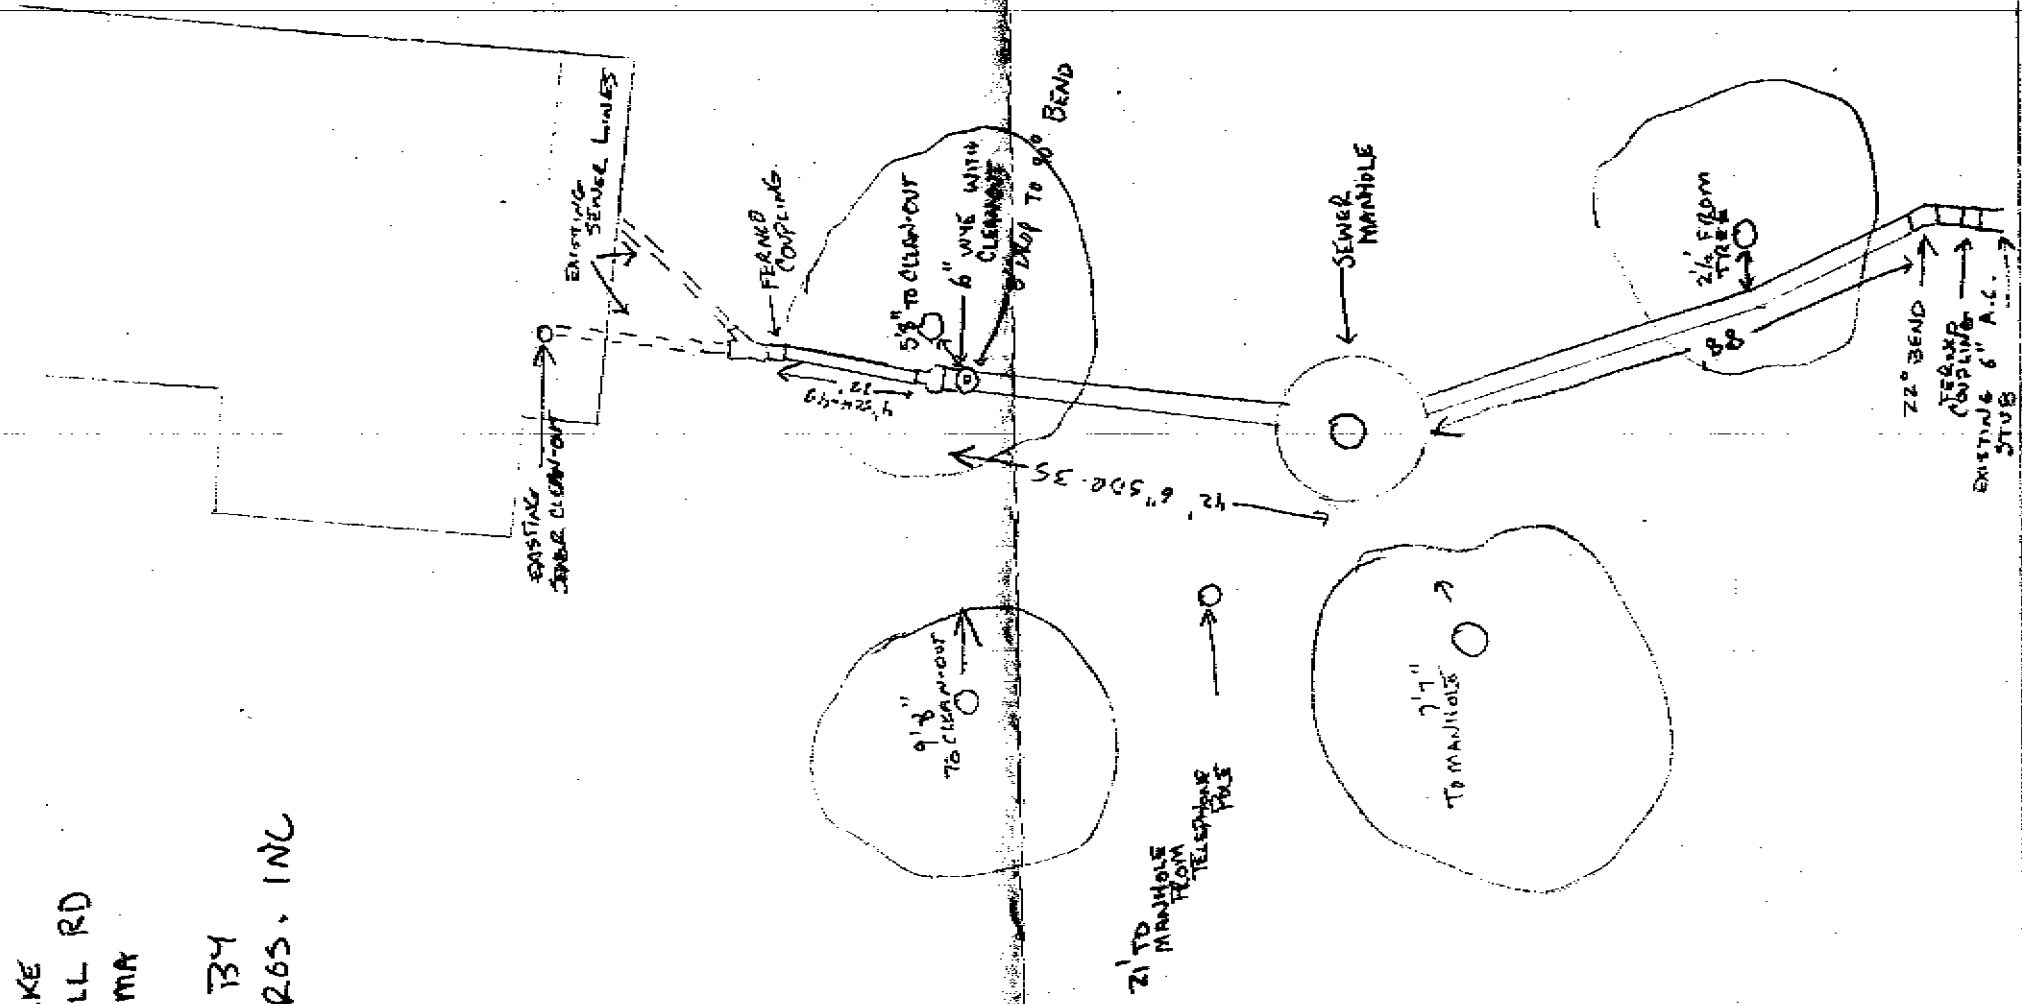


MOONHILL RD

DATE _____

TOWN OF LEXINGTON — BOARD OF PUBLIC WORKS

SEWER DIVISION

Sketch of Service Here **29**

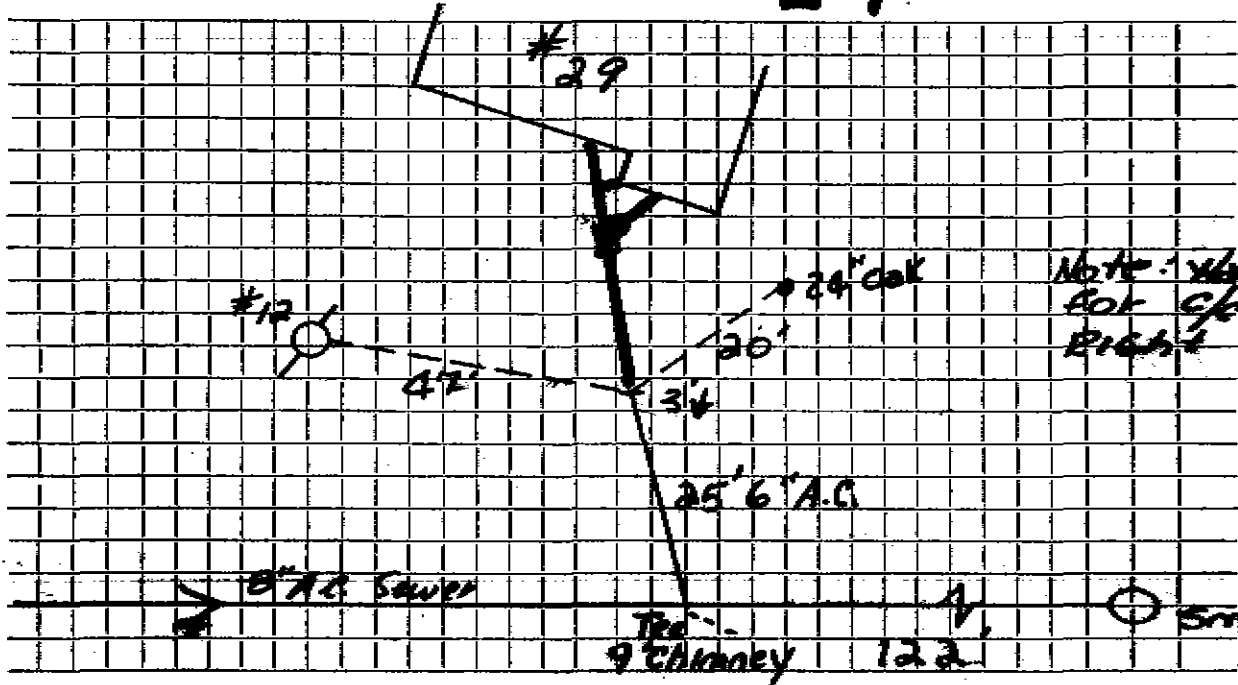

Note: Watch out for C/P at Right of Service

Connection made in Street. Work completed

Remarks:
.....
.....